

NEWTON

Ø40

10-16-74

MISSISSIPPI  
 BOARD OF WATER COMMISSIONERS CODED  
 416 North State Street  
 Jackson, Mississippi 39201

WATER WELL DRILLERS LOG

10-16-1974 date well completed  
 U. L. Welch firm name  
 Newton county well located

LANDOWNER: N. Mc Gowan  
 Newton  
 Miss  
 (mailing address)

description of formations encountered	from	to
Yellow clay	0	22
Blue	22	100
Blue Sandy	100	150
Sand	150	220

WELL LOCATION:  
 sec. 19 T. 5 N. R. 11 E. W.  
 1/4 miles SW of Newton  
 (distance) (direction) (nearest town)

WELL PURPOSE: Home  
 (home, irrigation, municipal, industrial)

- WELL COMPLETION DATA:
- (1) diameter (inches) 2"
  - (2) total depth (feet) 220
  - (3) static water level (feet) 40 below top of ground.
  - (4) casing PVC (material), (depth) \_\_\_\_\_  
 \_\_\_\_\_ if telescope see back.  
 (size)
  - (5) screen 5' (length), (depth to top) \_\_\_\_\_  
 2" PVC (size) (material)
  - (6) pump 1 (HP), 400 (yield gpm)  
 200 (type power)
  - (7) electric log no (yes or no)
  - \_\_\_\_\_ (organization running log)
  - (8) how well bottom plugged \_\_\_\_\_


CODFD

RECEIVED  
 NOV 12 1974

DRILLERS REMARKS:

If well telescopes please  
sketch and show depths.

GROUND LEVEL

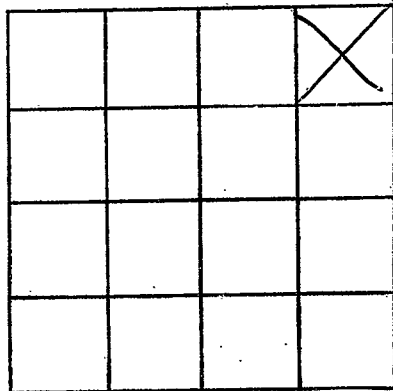

SECTION \_\_\_\_\_

Please indicate well location X.

ADDITIONAL INFORMATION

If more than one screen,  
show locations of each on sketch.