

Newton

Rtn 3/25/81  
for info



~~LANDOWNER~~

Ø42

3-17-81

MISSISSIPPI  
BOARD OF WATER COMMISSIONERS  
416 North State Street  
Jackson, Mississippi 39201

WATER WELL DRILLERS LOG

3-17-81

McDonald's Hill

Newton

date well completed

firm name

county well located

LANDOWNER:	description of formations encountered	from	to
<i>Sary Jones</i>			
<i>Rt # 2 Newton</i> (mailing address)	<i>clay</i>	<i>0</i>	<i>10</i>
WELL LOCATION: sec. <i>13</i> T <i>S</i> N R <i>11</i> E W <i>S</i> miles <i>2</i> of <i>Newton</i> (distance) (direction) (nearest town)	<i>sand</i>	<i>10</i>	<i>25</i>
WELL PURPOSE: <i>home</i> (home, irrigation, municipal, industrial)	<i>sand &amp; shale</i>	<i>25</i>	<i>75</i>
WELL COMPLETION DATA: (1) diameter (inches) <i>4 x 2</i>	<i>shale</i>	<i>75</i>	<i>110</i>
(2) total depth (feet) <i>500</i>	<i>sandy shale</i>	<i>110</i>	<i>180</i>
(3) static water level (feet) <i>195</i> below top of ground.	<i>shale &amp; sand</i>	<i>180</i>	<i>280</i>
(4) casing <i>PVC 395'</i> (material) (depth)	<i>sand</i>	<i>280</i>	<i>365</i>
<i>4" 122' 2" Black</i> (size) If telescope see back.	<i>sandy shale</i>	<i>365</i>	<i>412</i>
(5) screen <i>5' 495 to 500</i> (length) (depth to top)	<i>shale</i>	<i>412</i>	<i>445</i>
<i>2 55 Screen</i> (size) (material)	<i>rocks &amp; shells</i>	<i>445</i>	<i>485</i>
(6) pump <i>1 2000M</i> (HP) (yield gpm)	<i>green sand</i>	<i>485</i>	<i>500</i>
(type power) <i>25</i>			
(7) electric log (yes or no)			
(organization running log)			
(8) how well bottom plugged <i>valve</i>			
DRILLERS REMARKS:			


DEPT. OF NATURAL RESOURCES  
BUREAU OF LAND & WATER RESOURCES

MAR 25 1981

RECEIVED

If well telescopes please sketch and show depths.

GROUND LEVEL

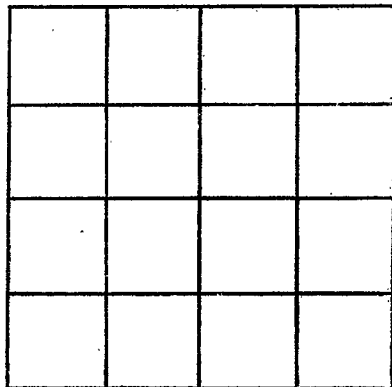

SECTION \_\_\_\_\_

Please indicate well location X.

ADDITIONAL INFORMATION

If more than one screen, show locations of each on sketch.