

MISSISSIPPI DEPARTMENT OF NATURAL RESOURCES

Bureau of Land and Water Resources

Southport Mall

P.O. Box 10631

Jackson, Mississippi 39209

CODED

WATER WELL DRILLERS LOG

NEWTON
044
12/8/81

Griner Drilling Service, Inc.

Newton

12-8-81 date well completed

Griner Drilling Service, Inc. firm name

Newton county well located

LANDOWNER:	description of formations encountered	from	to
<i>New and Hughes & Hughes</i> <i>P.O. Drawer 1487</i> <i>Natchez, MS 39120</i> (mailing address)			
WELL LOCATION: <i>823'N + 820'E</i> sec. <i>27 T. 5 N</i> R. <i>11 E SW/4</i>	<i>streaked mostly clay</i>	<i>420</i>	<i>567</i>
<i>No. 1</i> <i>Pierce</i> miles _____ of _____ (distance) (direction) (nearest town)	<i>streaked sand</i>	<i>567</i>	<i>651</i>
WELL PURPOSE: <i>oil field supply</i> (home, irrigation, municipal, industrial)			
WELL COMPLETION DATA:			
(1) diameter (inches) <i>3"</i>			
(2) total depth (feet) <i>651</i>			
(3) static water level (feet) <i>100'</i> ^(below) _{above} top of ground.			
(4) casing <i>steel</i> , <i>651'</i> (material) (depth)			
<i>3"</i> (size) if telescope see back.			
(5) screen <i>84'</i> , <i>567'</i> (length) (depth to top)			
<i>3'</i> , <i>perforated</i> (size) (material)			
(6) pump _____ <i>70</i> (HP) (yield gpm)			
<i>AC</i> (type power)			
(7) electric log _____ (yes or no)			
_____ (organization running log)			
(8) how well bottom plugged <i>orange</i> <i>peel</i>			
DRILLERS REMARKS:			

CODED


DEPT. OF NATURAL RESOURCES
BUREAU OF LAND & WATER RESOURCES

JAN 15 1982

RECEIVED

If well telescopes please sketch and show depths.

GROUND LEVEL

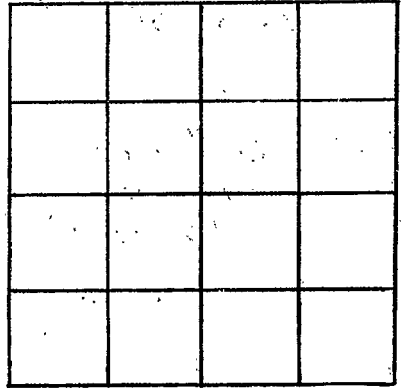

SECTION _____

Please indicate well location X.

ADDITIONAL INFORMATION

If more than one screen,
show locations of each on sketch.