

**NEWTON**  
 2000  
 6-3-76

**MISSISSIPPI**  
**BOARD OF WATER COMMISSIONERS**  
 416 North State Street  
 Jackson, Mississippi 39201

**WATER WELL DRILLERS LOG**

6.3.76 13P McDonald + Hill NEWTON  
 date well completed firm name county well located

**LANDOWNER:**  
GLENN Hollingsworth  
Rt 1 NEWTON BOX 182  
 (mailing address)

**WELL LOCATION:**  
 sec 1 T 5N R 11E  
 S W  
1/2 miles WEST of Newton  
 (distance) (direction) (nearest town)

**WELL PURPOSE:** HOME  
 (home, irrigation, municipal, industrial)

- WELL COMPLETION DATA:**
- diameter (inches) 4"
  - total depth (feet) 395'
  - static water level (feet) 90' below above-ground top of ground.
  - casing DVC 290'  
 (material) (depth)  
4" If telescope see back.  
 (size)
  - screen \_\_\_\_\_  
 (length) (depth to top)  
 (size) (material)
  - pump 1/2 sub 8  
 (HP) (yield gpm)  
E  
 (type power)
  - electric log \_\_\_\_\_  
 (yes or no)  
 (organization running log)
  - how well bottom plugged OPEN

description of formations encountered	from	to
Clay	0	30
Shale	30	50
Sandy Shale	50	60
Sand	60	214
Brown Sand	214	260
Soft shale & sand	260	285
Shale	285	330
Shale & P.H.	330	340
SAND	340	395


**DRILLERS REMARKS:**

JUN 11 1976

MISS. Bd. of WATER COMMISSIONERS

If well telescopes please sketch and show depths.

GROUND LEVEL

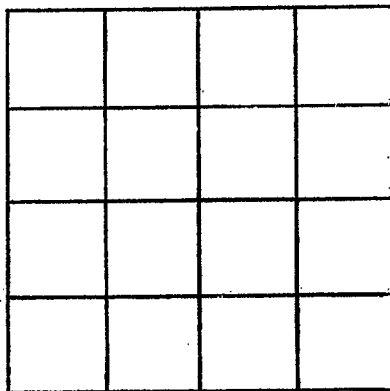

SECTION \_\_\_\_\_

Please indicate well location X.

ADDITIONAL INFORMATION

If more than one screen,  
show locations of each on sketch.