

**MISSISSIPPI  
BOARD OF WATER COMMISSIONERS**  
416 North State Street  
Jackson, Mississippi 39201

**WATER WELL DRILLERS LOG**

Newton  
Ø 2001  
7-28-76

13P

7-28-76 19 Wellington Drilling Serv. Newton  
date well completed firm name county well located


LANDOWNER:	description of formations encountered	from	to
<u>Wedge Farm, Sunnyside</u>	<u>Sandy</u>	<u>0</u>	<u>35</u>
<u>Newton, Miss -</u> (mailing address)	<u>Surface Sand</u>	<u>35</u>	<u>120</u>
	<u>Sandy Clay</u>	<u>120</u>	<u>211</u>
	<u>Brown Clay</u>	<u>211</u>	<u>336</u>
	<u>Water Bearing Sand</u>	<u>230</u>	<u>264</u>
<b>WELL LOCATION:</b>			
sec. <u>3</u> T. <u>5</u> (N) R. <u>11</u> (E)			
<u>1/2</u> miles <u>W</u> of <u>Newton</u> (distance) (direction) (nearest town)			
<b>WELL PURPOSE:</b> <u>Home</u> (home, irrigation, municipal, industrial)			
<b>WELL COMPLETION DATA:</b>			
(1) diameter (inches) <u>4 1/2"</u>			
(2) total depth (feet) <u>261</u>			
(3) static water level (feet) <u>90'</u> below top of ground.			
(4) casing <u>P.V.C. 120'</u> + <u>131' of 2" galv.</u> (material) (depth) (size) <u>telescope see back.</u>			
(5) screen <u>10'</u> (length) (depth to top) <u>2"</u> (size) <u>Steel</u> (material)			
(6) pump <u>1 1/4</u> (HP) <u>35</u> (yield gpm) <u>Elec</u> (type power)			
(7) electric log <u>NO</u> (yes or no) (organization running log)			
(8) how well bottom plugged <u>B.W.V.</u>			
<b>DRILLERS REMARKS:</b>			

**RECEIVED**  
AUG 25 1976

MISS. BD. OF WATER COMM.

If well telescopes please sketch and show depths.

GROUND LEVEL

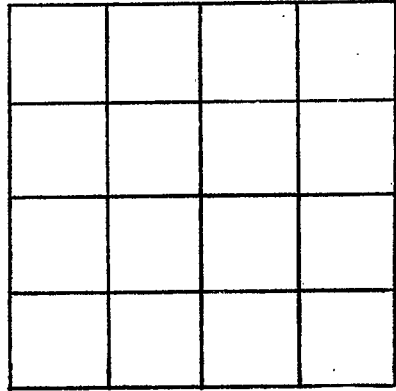

SECTION \_\_\_\_\_

Please indicate well location X.

ADDITIONAL INFORMATION

If more than one screen, show locations of each on sketch.