

NEWTON

0 2000

6/13/78

MISSISSIPPI BOARD OF WATER COMMISSIONERS  
416 North State Street  
Jackson, Mississippi 39201

WATER WELL DRILLERS LOG

6-13  
date well completed

1978 R. B. Wilbourn & S. Newton  
firm name county well located

LANDOWNER: Faug. Boyd N

R. L. Box 9A

Newton Miss 39345  
(mailing address)

description of formations encountered

from to

Red clay	0	20'
Red sand & rock	20'	150'
Water sand	150'	230'
	230'	250'

WELL LOCATION:

sec. 2 T 5 N R 4 E  
S W  
miles 5.0 S.E. of Newton  
(distance) (direction) (nearest town)

WELL PURPOSE: Home  
(home, irrigation, municipal, industrial)

WELL COMPLETION DATA:

- (1) diameter (inches) 2"
- (2) total depth (feet) 250'
- (3) static water level (feet) 40' below above top of ground.
- (4) casing galv. 250'  
(material) (depth)  
(size) If telescope see back.
- (5) screen 5'  
(length) (depth to top)  
2" 8. Steel  
(size) (material)
- (6) pump 1 15  
(HP) (yield gpm)  
elec.  
(type power)
- (7) electric log no.  
(yes or no)  
(organization running log)
- (8) how well bottom plugged B.W.U.


DRILLERS REMARKS:

RECEIVED  
JUN 29 1978

MISS. BD. OF WATER COMMISSIONERS

If well telescopes please sketch and show depths.

GROUND LEVEL

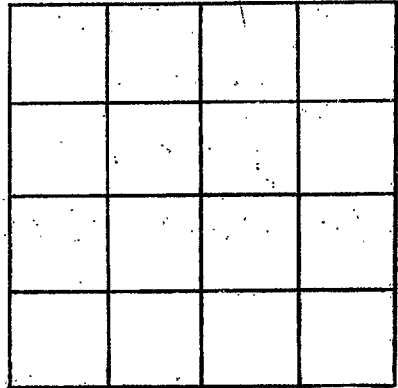

SECTION \_\_\_\_\_

Please indicate well location X.

ADDITIONAL INFORMATION

If more than one screen,  
show locations of each on sketch.