

NEWTON
 0 2003
 10-16-78

MISSISSIPPI
 BOARD OF WATER COMMISSIONERS
 416 North State Street
 Jackson, Mississippi 39201

WATER WELL DRILLERS LOG

10-16-78 19 McDonald & Hill Newton
 date well completed firm name county well located

LANDOWNER: Hardy Hill Deer Club Gene Gibbs (Hunting Club) Lawrence (mailing address)	Description of formations encountered	from	to
	Clay & st sand	0	20
	Blue shale	20	160
	white shab at rock	160	220
	sandy shab & shells	220	260
	fine sand & shale	260	290
	sand	290	310

WELL LOCATION:
 sec 31 T 5 N R 11 E
 10 miles S/E of Lawrence
 (distance) (direction) (nearest town)

WELL PURPOSE: Home
 (home, irrigation, municipal, industrial)

WELL COMPLETION DATA:

(1) diameter (inches) 9"
 (2) total depth (feet) 310'
 (3) static water level (feet) 173' below top of ground.
 (4) casing PVC 325' (material), (depth)
 2" (size) if telescope see back.
 (5) screen 5' 325' to 310' (length), (depth to top)
 2" (size), PVC (material)
 (6) pump 1 390 PM (HP), (field gpm)
 F (type power)
 (7) electric log (yes or no)
 (organization running log)
 (8) how well bottom plugged Value


RECEIVED
 OCT 23 1978

MISS. BD. OF WATER COMM.

DRILLERS REMARKS:

If well telescopes please sketch and show depths.

GROUND LEVEL

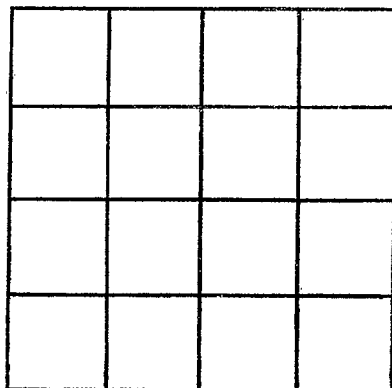

SECTION _____

Please indicate well location X.

ADDITIONAL INFORMATION

If more than one screen,
show locations of each on sketch.