

Newton
2005

MISSISSIPPI
BOARD OF WATER COMMISSIONERS
416 North State Street
Jackson, Mississippi 39201

12-28-79
12-28-79

WATER WELL DRILLERS LOG

McDonald Hill Newton
firm name county well located

LANDOWNER:

Herman Groter
314 North Main St.
Newton (mailing address)

description of formations encountered

from to

clay & sand	0	30
shale	30	60
sandy shale & sandstone rock	60	130
fine sand	130	145
shale & fine sand	145	180
shale & lignite	180	205
sand	205	240

WELL LOCATION:

sec. 12 T 5 N R 11 E
4 miles S.E. of Newton
(distance) (direction) (nearest town)

WELL PURPOSE: home
(home, irrigation, municipal, industrial)

WELL COMPLETION DATA:


- (1) diameter (inches) 4"
- (2) total depth (feet) 240
- (3) static water level (feet) 82' below top of ground.
- (4) casing PUC 235'
(material) (depth)
4" if telescope see back.
(size)
- (5) screen 5' 235 to 240'
(length) (depth to top)
1/2" PUC
(size) (material)
- (6) pump 3/4 10 GPM
(HP) (yld/gpm)
F
(type power)
- (7) electric log _____
(yes or no)
(organization running log)
- (8) how well bottom plugged value

DRILLERS REMARKS:

DEPT. OF NATURAL RESOURCES
BUREAU OF LAND & WATER RESOURCES
JAN 8 1980
RECEIVED

If well telescopes please sketch and show depths.

GROUND LEVEL

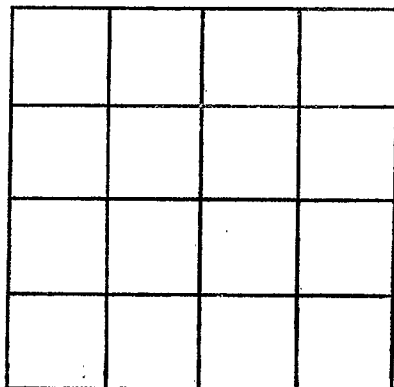

SECTION _____

Please indicate well location X.

ADDITIONAL INFORMATION

If more than one screen,
show locations of each on sketch.