

NEWTON  
Φ 2007  
11-22-80

MISSISSIPPI  
 BOARD OF WATER COMMISSIONERS  
 416 North State Street  
 Jackson, Mississippi 39201

WATER WELL DRILLERS LOG

10-22-80 19 McDonald & Hill Newton  
 date well completed firm name county well located

LANDOWNER:	description of formations encountered	from	to
<u>Robert A. Bauer</u>	<u>Clay &amp; sand</u>	<u>0</u>	<u>20</u>
<u>Mrs. Mellan Lambert Supply</u>	<u>sand &amp; clay</u>	<u>20</u>	<u>45</u>
<u>Newton</u> (mailing address)	<u>shale</u>	<u>45</u>	<u>100</u>
	<u>fine sand &amp; shale</u>	<u>100</u>	<u>175</u>

WELL LOCATION:  
 sec 17 T S N 11 R E  
4 miles SW of Newton  
 (distance) (direction) (nearest town)

WELL PURPOSE: home  
 (home, irrigation, municipal, industrial)

- WELL COMPLETION DATA:
- (1) diameter (inches) 2"
  - (2) total depth (feet) 180'
  - (3) static water level (feet) 30' below top of ground.
  - (4) casing PVC, 175'  
 (material) (depth)  
2" if telescope see back.  
 (size)
  - (5) screen 5', 175 to 180  
 (length) (depth to top)  
2" (size) PVC (material)
  - (6) pump 1/2, 6000  
 (HP) (yield gpm)  
K (type power)
  - (7) electric log —  
 (yes or no)  
 (organization running log)
  - (8) how well bottom plugged water

DEPT. OF NATURAL RESOURCES  
 BUREAU OF LAND & WATER RESOURCES


OCT 28 1980

RECEIVED

DRILLERS REMARKS:

If well telescopes please sketch and show depths.

GROUND LEVEL

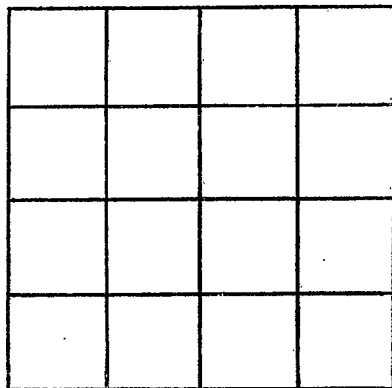

SECTION \_\_\_\_\_

Please indicate well location X.

ADDITIONAL INFORMATION

If more than one screen, show locations of each on sketch.