

MISSISSIPPI DEPARTMENT OF NATURAL RESOURCES

Bureau of Land and Water Resources

Southport Mall

P.O. Box 10631

Jackson, Mississippi 39209

WATER WELL DRILLERS LOG

Newton  
02008

4/8/83 1983 Jerry Drilling Co Newton  
date well completed firm name county well located

LANDOWNER:	description of formations encountered	from	to
<u>Bentwell Farms</u>			
<u>Rt 2 Newton, Miss</u> (mailing address)	<u>sand &amp; clay</u>	<u>18</u>	<u>75</u>
	<u>clay</u>	<u>75</u>	<u>200</u>
	<u>sand</u>	<u>200</u>	<u>230</u>

WELL LOCATION:  
sec. 36 T. 5 N R. 11 E  
S W  
10 miles SE of Newton  
(distance) (direction) (nearest town)

WELL PURPOSE: farm  
(home, irrigation, municipal, industrial)

WELL COMPLETION DATA:

(1) diameter (inches) 4"

(2) total depth (feet) 230'

(3) static water level (feet) 50 <sup>(below)</sup> above top of ground.

(4) casing PVC 200'  
(material) (depth)  
2"  
(size) if telescope see back.

(5) screen 20' 210'  
(length) (depth to top)  
2" PVC  
(size) (material)

(6) pump 1 15  
(HP) (yield gpm)  
sub  
(type power)

(7) electric log No  
(yes or no)  
(organization running log)


(8) how well bottom plugged wash  
value

DRILLERS REMARKS:  
Bad water

DEPT. OF NATURAL RESOURCES  
BUREAU OF LAND & WATER RESOURCES  
AUG 13 1984  
RECEIVED

If well telescopes please sketch and show depths.

GROUND LEVEL

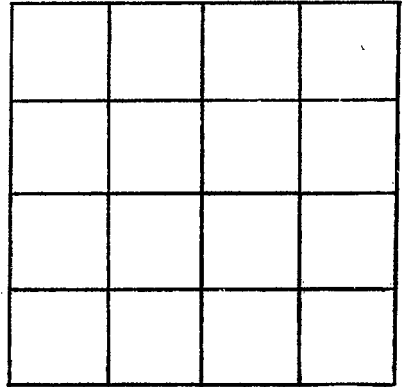

SECTION \_\_\_\_\_

Please indicate well location X.

ADDITIONAL INFORMATION

If more than one screen,  
show locations of each on sketch.