

3P3

P 301

WATER WELL DRILLERS LOG

5-17-61

Date: 5-17, 1961, Driller: W. L. Welch County Newton

(Name)

(1) Owner of Land: Ross Holmes
(Name)
Newton Miss
(Address)

Description & Color of Materials
Sand, Clay, Red Clay, Shell, etc.

Thick-
ness
Feet

Depth
Feet

Clay

45 0-45

Sand

95 45-118

(2) Location: NE 1/4, NW 1/4, Sec 31 T5R12
6 miles S. East of Newton
(distance) (direction) (Nearest Town)

(3) Topography: (Hilly) (Flat) (Level)

(4) Purpose of Well: Domestic
(Domestic Irrigation
Municipal, Industrial, Other)

Information upon completion of well:


- (1) Diameter 2" inches.
- (2) Total Depth 110 feet.
- (3) Water Level 40 feet below top of ground.
- (4) Cased to 110, Size 2"
- (5) Screen: Size #70, Length 10'
- (6) Were any formations sealed against pollution?

yes, no.

If YES depth of formation _____

Why _____

Drillers Remarks: _____

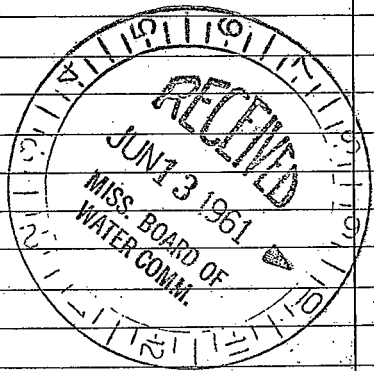

(Use Back Side)

Well No. 16

