

NEWTON

WATER WELL DRILLERS LOG

P 300^P

Date: 5-29, 1961, Driller: J. L. Shelch County Newton
 5-29-61 (Name)

(1) Owner of Land: J. Beeman
 (Name)
Hickory Miss
 (Address)

(2) Location: SE 1/4 NW 1/4, Sec 27, T6 R12
5 miles South of Hickory
 (distance) (direction) (Nearest Town)

(3) Topography: (Hilly) (Flat) (Level)

(4) Purpose of Well: Domestic
 (Domestic Irrigation
 Municipal, Industrial, Other)

Description & Color of Materials Sand, Clay, Red Clay, Shell, etc.	Thick- ness Feet	Depth Feet
<u>Clay</u>	<u>48</u>	<u>48</u>
<u>Blue</u>	<u>187</u>	<u>235</u>
<u>Sand</u>	<u>71</u>	<u>306</u>

Information upon completion of well:

(1) Diameter 24 inches.

(2) Total Depth 306 feet.

(3) Water Level 149 feet below top of ground.

(4) Cased to 189, Size 24


(5) Screen: Size None, Length _____

(6) Were any formations sealed against pollution?
 _____ yes, no.

If YES depth of formation _____

Why _____

Drillers Remarks: _____

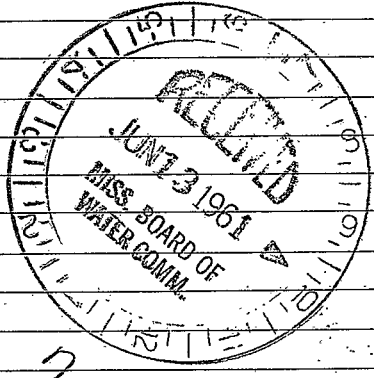

2

(Use Back Side)

Well No. 2

[The page contains extremely faint and illegible text, likely bleed-through from the reverse side of the document. The text is scattered across the page and cannot be transcribed accurately.]