

3P6

P

WATER WELL DRILLERS LOG

3-21-62

Date: 3-21, 1962, Driller: H. L. Sheldahl County Newton

(Name)

(1) Owner of Land M. Y. Mills
(Name)
Newton Miss
(Address)
(2) Location: NW SE
SE 1/4, NW 1/4, Sec. 30 T. 5 R. 12
5 miles SE of Newton
(distance) (direction) (Nearest Town)
(3) Topography: (Hilly) (Flat) (Level)
(4) Purpose of Well: Domestic
(Domestic Irrigation
Municipal, Industrial, Other)


Description & Color of Materials Sand, Clay, Red Clay, Shell, etc.	Thick- ness Feet	Depth Feet
Clay	20	0-20
R Sand	50	20-70
Blue	50	70-120
Grey + Shell	70	120-190
Sand	57	190-247

Information upon completion of well:

(1) Diameter 3 1/2 inches.
(2) Total Depth 244 feet.
(3) Water Level 110 feet below top of ground.
(4) Cased to 153, Size 2"
(5) Screen: Size None, Length _____
(6) Were any formations sealed against pollution?
_____ yes, _____ no.

If YES depth of formation _____
Why _____

Drillers Remarks: _____

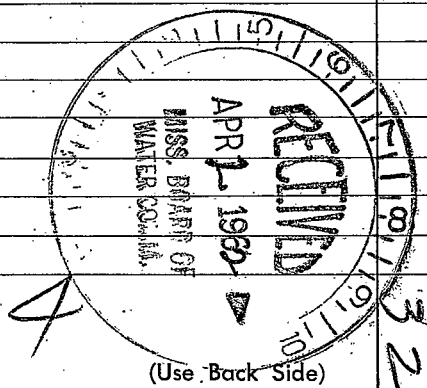

(Use Back Side)

Well No. 32

