


3 P 7
7-5-62

WATER WELL DRILLERS LOG

Date: 7-5, 1962, Driller: W. L. Shelch County Newton
(Name)

	Description & Color of Materials Sand, Clay, Red Clay, Shell, etc.	Thick- ness Feet	Depth Feet
(1) Owner of Land: <u>Charlie Godwin</u> (Name) <u>Newton Miss</u> (Address)	Clay	6	0-6
(2) Location: <u>SE 1/4, NW 1/4, Sec. 18 T5 R12</u> <u>4</u> miles <u>S East</u> , of <u>Newton</u> (distance) (direction) (Nearest Town)	Blue Shell	37	6-43
(3) Topography: <input checked="" type="checkbox"/> (Hilly) <input type="checkbox"/> (Flat) <input type="checkbox"/> (Level)	Sandy shell	43	43-86
(4) Purpose of Well: <u>Domestic</u> (Domestic Irrigation Municipal, Industrial, Other)		41	86-129
Information upon completion of well:			
(1) Diameter <u>2</u> inches.			
(2) Total Depth <u>129</u> feet.			
(3) Water Level <u>30</u> feet below top of ground.			
(4) Cased to <u>82</u> , Size <u>2"</u>			
(5) Screen: Size <u>None</u> Length _____			
(6) Were any formations sealed against pollution? _____ yes, <input checked="" type="checkbox"/> no.			
If YES depth of formation _____			
Why _____			
Drillers Remarks: _____			

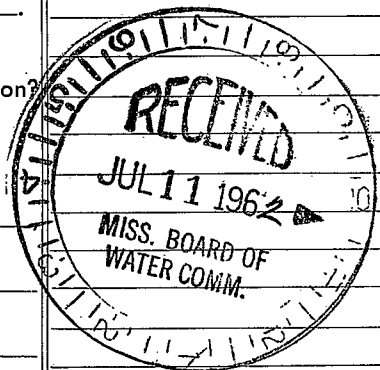

5

43

Well No.

(Use Back Side)

17