

3P 9

P

10-23-62

WATER WELL DRILLERS LOG

Date: 10-23, 1962 Driller: W L Welch County: Newton
(Name)

(1) Owner of Land: Jan Harrison
(Name)
Newton Miss
(Address)

(2) Location: NE 1/4, NE 1/4, Sec. 5 T5R12
4 miles East, of Newton
(distance) (direction) (Nearest Town)

(3) Topography: ✓
(Hilly) (Flat) (Level)

(4) Purpose of Well: ✓
(Domestic Irrigation
Municipal, Industrial, Other)

Description & Color of Materials Sand, Clay, Red Clay, Shell, etc.	Thick- ness Feet	Depth Feet
Clay	32	0-32
Blue	32	32-64
Brown	21	64-85
Blue	31	85-116
Sand	41	116-157

Information upon completion of well:

(1) Diameter 2 inches.

(2) Total Depth 157 feet.

(3) Water Level 72 feet below top of ground.

(4) Cased to 157, Size 2"


(5) Screen: Size 8 slot, Length 10'

(6) Were any formations sealed against pollution?
_____ yes, ✓ no.

If YES depth of formation _____

Why _____

Drillers Remarks: _____

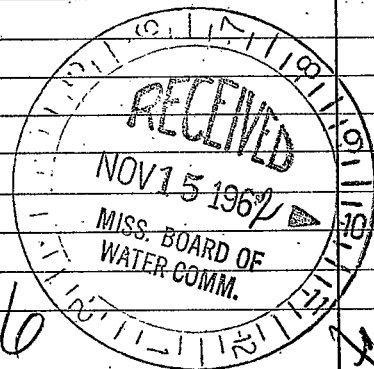

(Use Back Side)

Well No. 49

