

NEWTON

MISSISSIPPI BOARD OF WATER COMMISSIONERS

P 10

2-28-63

WATER WELL DRILLERS LOG

Date: 2-28, 1963, Driller: U. L. Shelton, Newton (Name)

(1) Owner of Land: B. W. Baucum (Name)

Newton Miss (Address)

(2) Location: SE 1/4, NE 1/4, Sec. 5 T5 R12

4 miles S. E. of Newton (distance) (direction) (Nearest Town)

(3) Topography: (Hilly) (Flat) (Level)

(4) Purpose of Well: Domestic (Domestic Irrigation Municipal, Industrial, Other)

Description & Color of Materials Sand, Clay, Red Clay, Shell, etc.	Thick- ness Feet	Depth Feet
R clay	22	0-22
B. + shell	31	22-53
blue	63	53-116
Sand	54	116
		↓
		170

Information upon completion of well:

(1) Diameter 2" inches.

(2) Total Depth 170 feet.

(3) Water Level 65 feet below top of ground.

(4) Cased to 170, Size 2"


(5) Screen: Size 2", Length 10'

(6) Were any formations sealed against pollution? yes, no.

If YES depth of formation

Why

Drillers Remarks:

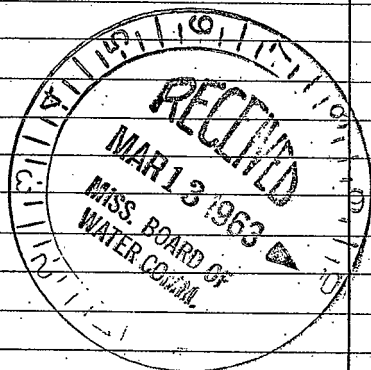

(Use Back Side)

Retain this copy for your office files.

Well No. 59

