

Newton

MISSISSIPPI BOARD OF WATER COMMISSIONERS

P

3 P12

9-66

WATER WELL DRILLERS LOG

Date: 9-7, 1966, Driller: U. L. Welch County Newton  
(Name)

- (1) Owner of Land: Helen H Davis  
(Name)  
Newton Miss  
(Address)
- (2) Location: SW 1/4, SE 1/4, Sec. 32 T. 5 R. 12  
8 miles SE, of Newton  
(distance) (direction) (Nearest Town)
- (3) Topography: ✓  
(Hilly) (Flat) (Level)
- (4) Purpose of Well: Domestic  
(Domestic Irrigation  
Municipal, Industrial, Other)

Information upon completion of well:

- (1) Diameter 2 inches.
- (2) Total Depth 80 feet.
- (3) Water Level 38 feet below top of ground.
- (4) Cased to 80, Size 2".
- (5) Screen: Size 60 Length 6'.
- (6) Were any formations sealed against pollution?  
\_\_\_\_\_ yes, ✓ no.

If YES depth of formation \_\_\_\_\_

Why \_\_\_\_\_


Drillers Remarks: \_\_\_\_\_

Description & Color of Materials  
Sand, Clay, Red Clay, Shell, etc.

Thick-  
ness  
Feet

Depth  
Feet

8 clay  
5 clay 37 0-32  
Sandy  
Sand 48 32-80

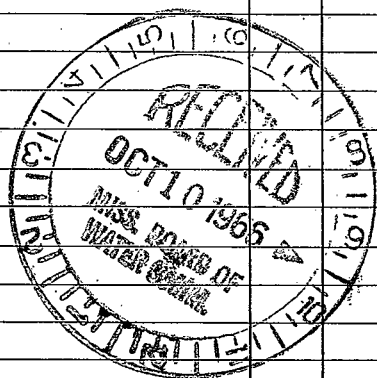

Well No.

117

(Use Back Side)

Retain this copy for your office files.

2

1. The first part of the paper is devoted to a discussion of the

main results.

2. The second part is devoted to a discussion of the

main results.

3. The third part is devoted to a discussion of the

main results.

4. The fourth part is devoted to a discussion of the

main results.

5. The fifth part is devoted to a discussion of the

6.

7. The sixth part is devoted to a discussion of the

main results.

8. The seventh part is devoted to a discussion of the