

NEWTON  
P13

# WATER WELL DRILLERS LOG

P

Date: 8/17/64, 1964, Driller: M<sup>e</sup> Donald & Hill Inc County Newton  
(Name)

(1) Owner of Land: CLAUDE LITTLE  
(Name)

Hickory MISS  
(Address)

(2) Location: 1/4, 1/4, Sec. 14 5N 12E  
T. R

3 miles South, of Millington  
(distance) (direction) (Nearest Town)

(3) Topography: X  
(Hilly) (Flat) (Level)

(4) Purpose of Well: DOMESTIC  
(Domestic Irrigation  
Municipal, Industrial, Other)

Description & Color of Materials Sand, Clay, Red Clay, Shell, etc.	Thick- ness Feet	Depth Feet
<u>CLAY</u>	<u>0</u>	<u>135</u>
<u>SAND</u>	<u>15</u>	<u>22</u>
<u>SAND ST SHALE</u>	<u>22</u>	<u>90</u>
<u>SHALE</u>	<u>90</u>	<u>140</u>
<u>SHALE ST ROCK</u>	<u>140</u>	<u>294</u>
<u>SAND</u>	<u>294</u>	<u>330</u>

### Information upon completion of well:

(1) Diameter 3 3/8 inches, 7 1/2" Hole

(2) Total Depth 330' feet.

(3) Water Level 60' feet below top of ground.

(4) Cased to 122', Size 4"


(5) Screen: Size \_\_\_\_\_, Length \_\_\_\_\_

(6) Were any formations sealed against pollution?  
\_\_\_\_\_ yes, \_\_\_\_\_ no.

If YES depth of formation \_\_\_\_\_

Why \_\_\_\_\_

Drillers Remarks: MATERIAL LIST ON BACK

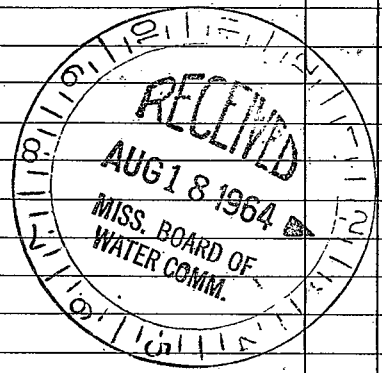

Well No.

(Use Back Side)

100 = 1 1/4" PLUGS AND

100 = 1" =

1 = 1 1/4" x 12 NIPPLE

4 = 1" x 12 =

1 = 1 1/4" FEE

1 = 1" ELL

2 = 1 1/4" adapters w/ caps

2 = 1" =

1 = 1 1/4" FOOT VALVE

1 = 1 1/4" x 1" x 1" =

1 = 1" x 12 NIPPLE