

3 P 14
9-3-65

P

WATER WELL DRILLERS LOG

Date: 9-3, 1965, Driller: W. L. Welch County Newton
(Name)

(1) Owner of Land: R. Gary
(Name)
Newton Miss
(Address)

(2) Location: SE 1/4, SE 1/4, Sec. 5 T5R12
4 miles SE, of Newton
(distance) (direction) (Nearest Town)

(3) Topography: L
(Hilly) (Flat) (Level)

(4) Purpose of Well: Domestic
(Domestic Irrigation
Municipal, Industrial, Other)

Description & Color of Materials Sand, Clay, Red Clay, Shell, etc.	Thick- ness Feet	Depth Feet
<u>R. Clay</u>	<u>16</u>	<u>0-16</u>
<u>Shell</u>	<u>69</u>	<u>16-85</u>
<u>Brown</u>	<u>53</u>	<u>85-138</u>
<u>Gray</u>	<u>32</u>	<u>138-170</u>
<u>Sand</u>	<u>71</u>	<u>170</u>
		<u>241</u>

Information upon completion of well:

(1) Diameter 7 inches.

(2) Total Depth 241 feet.

(3) Water Level 87 feet below top of ground.

(4) Cased to 241, Size 2"


(5) Screen: Size 60 Mesh Length 10'

(6) Were any formations sealed against pollution?
_____ yes, no.

If YES depth of formation _____

Why _____

Drillers Remarks: _____

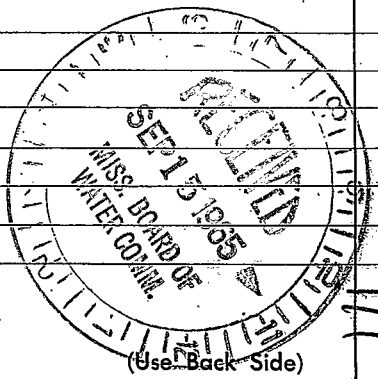

Well No. 111

