

WATER WELL DRILLERS LOG

Date: 12-7, 1966, Driller: H. L. Welch County Newton

(Name)

(1) Owner of Land: J. G. Wall
(Name)
Newton Miss
(Address)

Description & Color of Materials
Sand, Clay, Red Clay, Shell, etc.

Thick-
ness
Feet

Depth
Feet

R. Clay
Gard

32 0-32
36 32-68

(2) Location: E 1/4, SE 1/4, Sec. 31 T. 5 R. 12
8 miles S E of Newton
(distance) (direction) (Nearest Town)

(3) Topography: (Hilly) (Flat) (Level)

(4) Purpose of Well: Domestic
(Domestic Irrigation
Municipal, Industrial, Other)


Information upon completion of well:

- (1) Diameter 2 inches.
- (2) Total Depth 68 feet.
- (3) Water Level 42 feet below top of ground.
- (4) Cased to 68, Size 2"
- (5) Screen: Size 2 1/2, Length 5'
- (6) Were any formations sealed against pollution?
no

If YES depth of formation _____

Why _____

Drillers Remarks: _____

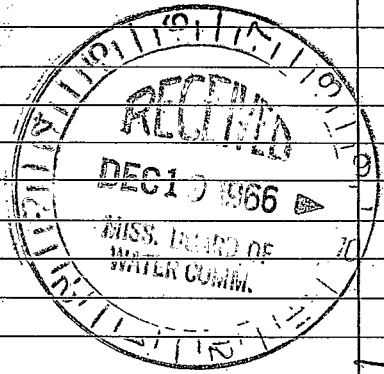

1971

Well No.

(Use Back Side)

