

Newton
P18
10-67

**MISSISSIPPI  
BOARD OF WATER COMMISSIONERS**  
416 North State Street  
Jackson, Mississippi 39201

**WATER WELL DRILLERS LOG**

10-24 1967 W. S. Shelch Newton  
 date well completed firm name county well located

**LANDOWNER:**  
Samuel Edwards  
Newton Miss.  
 (mailing address)

description of formations encountered	from	to
	<u>Yellow clay</u>	<u>0</u>
<u>Blue</u>	<u>18</u>	<u>64</u>
<u>Blue + Sandy</u>	<u>64</u>	<u>86</u>
<u>White Sand</u>	<u>86</u>	<u>108</u>

**WELL LOCATION:**  
 sec. 7 T. 5 N R. 12 E  
                         S                                W  
5 miles W of Newton  
 (distance) (direction) (nearest town)

**WELL PURPOSE:**  
 (home, irrigation, municipal, industrial)

**WELL COMPLETION DATA:**


- (1) diameter (inches) 2"
- (2) total depth (feet) 119
- (3) static water level (feet) 18 below above top of ground.
- (4) casing 119 (material) (depth)  
 \_\_\_\_\_ if telescope see back.  
 (size)
- (5) screen 10', 108' (length) (depth to top)  
2", Brass (size) (material)
- (6) pump 1 HP, 1250 (HP) (yield gpm)  
elec. (type power)
- (7) electric log   ✓   (yes or no)  
 \_\_\_\_\_ (organization running log)
- (8) how well bottom plugged   no

**DRILLERS REMARKS:**



If well telescopes please sketch and show depths.

GROUND LEVEL

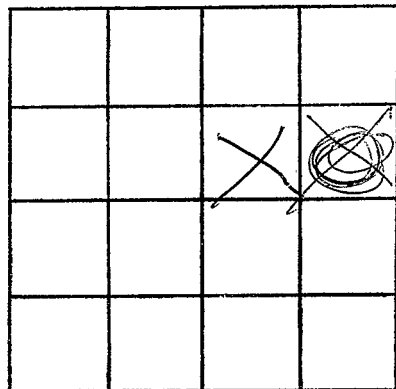

SECTION \_\_\_\_\_

Please indicate well location X.

ADDITIONAL INFORMATION

If more than one screen,  
show locations of each on sketch.