

Newton
P19
7-68

MISSISSIPPI
BOARD OF WATER COMMISSIONERS
416 North State Street
Jackson, Mississippi 39201

WATER WELL DRILLERS LOG

7-15-68 19 McDONALD + HILL NEWTON
date well completed firm name county well located

LANDOWNER: JOHNNIE WALL

Hickory Miss

(mailing address)

WELL LOCATION:

sec. 4 T 5 N R. 12 E
S W
5 miles SOUTH of Hickory
(distance) (direction) (nearest town)

WELL PURPOSE: HOME
(home, irrigation, municipal, industrial)

WELL COMPLETION DATA:

- (1) diameter (inches) 4"
- (2) total depth (feet) 420'
- (3) static water level (feet) 130 below above top of ground.
- (4) casing BLK 189'
(material) (depth)
4" if telescope see back.
(size)
- (5) screen NO NO
(length) (depth to top)
1/8 1/8
(size) (material)
- (6) pump 34 10
(HP) (yield gpm)
220
(type power)
- (7) electric log NO
(yes or no)
NO
(organization running log)
- (8) how well bottom plugged OPEN

description of formations encountered

from to


<u>Clay</u>	<u>7</u>	<u>18</u>
<u>Shale</u>	<u>18</u>	<u>80</u>
<u>SAND</u>	<u>80</u>	<u>164</u>
<u>Soft Shale</u>	<u>164</u>	<u>180</u>
<u>Shale</u>	<u>180</u>	<u>224</u>
<u>Granules</u>	<u>224</u>	<u>250</u>
<u>Shale</u>	<u>250</u>	<u>380</u>
<u>Sand</u>	<u>380</u>	<u>420</u>

DRILLERS REMARKS:

MISSISSIPPI
STATE BOARD OF
WATER COMMISSIONERS
JACKSON, MISSISSIPPI

If well telescopes please sketch and show depths.

GROUND LEVEL

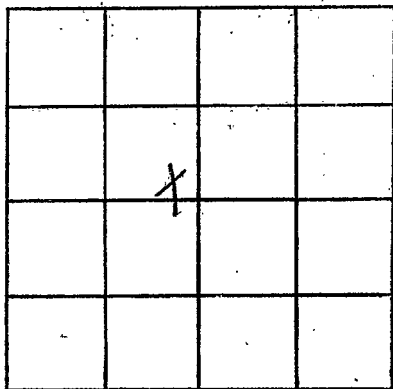

SECTION _____

Please indicate well location X.

ADDITIONAL INFORMATION

If more than one screen,
show locations of each on sketch.