

Newton
 P 20
 6-68 CODED

MISSISSIPPI
 BOARD OF WATER COMMISSIONERS
 416 North State Street
 Jackson, Mississippi 39201

WATER WELL DRILLERS LOG

6-8 1968 U. L. Welch Newton
 date well completed firm name county well located

LANDOWNER:
 Don Edwards
 Newton Miss
 (mailing address)

description of formations encountered	from	to
Yellow clay	0	12
S clay	12	22
Blue	22	76
Blue + sand	76	86
W sand	86	119

WELL LOCATION:
 sec 4 T 5 N R 12 E
 S W
 5 miles E of Newton
 (distance) (direction) (nearest town)

WELL PURPOSE:
 (home, irrigation, municipal, industrial)

- WELL COMPLETION DATA:
- (1) diameter (inches) 2"
 - (2) total depth (feet) 119
 - (3) static water level (feet) 18' below top of ground.
 - (4) casing Gal Steel, 10 9/16"
 (material) (depth)
 (size) if telescope see back.
 - (5) screen 10' (length), (depth to top)
 2" (size), Brass (material)
 - (6) pump 1 HP (HP), 1200 (yield gpm)
 electric (type power)
 - (7) electric log (yes or no)
 (organization running log)
 - (8) how well bottom plugged Steel

CODED


JUN 18 1968

MISS. Bd. of WATER COMMISSIONERS

DRILLERS REMARKS:

If well telescopes please sketch and show depths.

GROUND LEVEL

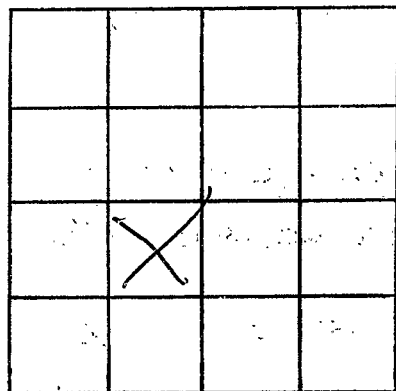

SECTION _____

Please indicate well location X.

ADDITIONAL INFORMATION

If more than one screen,
show locations of each on sketch.