

CODED

462

MISSISSIPPI
 BOARD OF WATER COMMISSIONERS
 416 North State Street
 Jackson, Mississippi 39201

CODED

WATER WELL DRILLERS LOG

Newton
P21
11-14-68

11.14.68 date well completed MCDONALD + HILL firm name NEWTON county well located

LANDOWNER: CHARLES GATES

Hickory Miss

(mailing address)

description of formations encountered

from

to

Clay
Shale

	0	18
	18	60
	60	220
	220	250
	250	330
	330	400

Sand
Soft Sandy Shale
Shale
SAND ST ROCKS

WELL LOCATION:

sec. 28 T 5 N R 12 E
 S W
5 miles SOUTH of Hickory
 (distance) (direction) (nearest town)


WELL PURPOSE:

HOME
(home, irrigation, municipal, industrial)

WELL COMPLETION DATA:

- (1) diameter (inches) 4"
- (2) total depth (feet) 400'
- (3) static water level (feet) 80' below above
top of ground.
- (4) casing BLACK, 273'
(material) (depth)
4"
(size) If telescope see back.
- (5) screen _____
(length) (depth to top)


(size) (material)
- (6) pump 1/2 10
(HP) (yield gpm)
220
(type power)
- (7) electric log NO
(yes or no)
NO
(organization running log)
- (8) how well bottom plugged OPEN

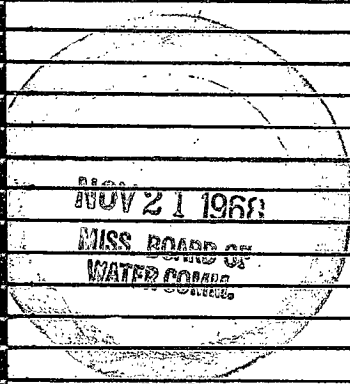

DRILLERS REMARKS:

If well telescopes please sketch and show depths.

GROUND LEVEL

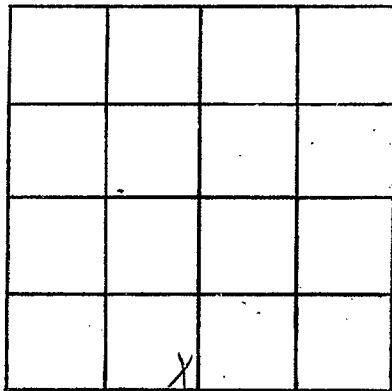

SECTION 28

Please indicate well location X.

ADDITIONAL INFORMATION

If more than one screen, show locations of each on sketch.