

Newton
P 22
11-27-68

MISSISSIPPI
BOARD OF WATER COMMISSIONERS
416 North State Street
Jackson, Mississippi 39201

Coded

WATER WELL DRILLERS LOG

CODED

11-27 1968 U. L. Shelch Newton
date well completed firm name county well located

LANDOWNER: Jack H Harris
Newton
Ginn
(mailing address)


description of formations encountered	from	to
Yellow Clay	0	18
Blue	18	43
Sandy Blue	43	65
Brown	65	86
Blue	86	118
Sand	118	170
		118
		312

WELL LOCATION:
sec. 4 T 5 N R 12 E
S W
4 miles E of Newton
(distance) (direction) (nearest town)

WELL PURPOSE:
(home, irrigation, municipal, industrial)

WELL COMPLETION DATA:

- (1) diameter (inches) 2"
- (2) total depth (feet) 170
- (3) static water level (feet) 51 below top of ground.
- (4) casing 40 steel 170 (material) (depth)
if telescope see back. (size)
- (5) screen 10' (length) (depth to top)
2" Brass (size) (material)
- (6) pump 1 1/2 HP 950 (type) (yield gpm)
- (7) electric log (yes or no)
(organization running log)
- (8) how well bottom plugged

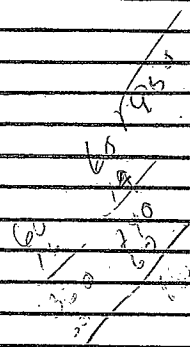


DEC 12 1968
MISS. BD. OF
WATER COMM.

DRILLERS REMARKS:

If well telescopes please sketch and show depths.

GROUND LEVEL

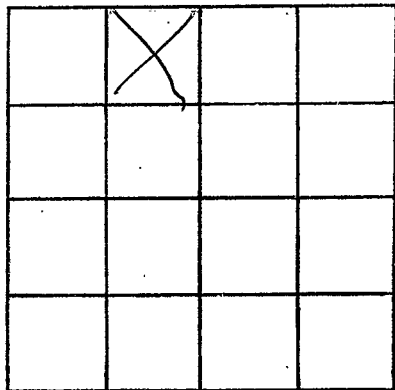

SECTION 4

Please indicate well location X.

ADDITIONAL INFORMATION

If more than one screen,
show locations of each on sketch.