

MISSISSIPPI
BOARD OF WATER COMMISSIONERS
416 North State Street
Jackson, Mississippi 39201

WATER WELL DRILLERS LOG

Newton
P23
9-69

Sept 1969 date well completed
Wilkinson Drilling firm name
Newton county well located

LANDOWNER:

Mr. Brock
Newton Miss
(mailing address)

description of formations encountered

from to

Yellow clay 0 40
Clay + Sand 40 95
Sand 95 135

WELL LOCATION:

sec. 4 T. 5 N R. 12 E
S W
9 miles SE of Newton
(distance) (direction) (nearest town)

WELL PURPOSE: home
(home, irrigation, municipal, industrial)

WELL COMPLETION DATA:


- (1) diameter (inches) 2
- (2) total depth (feet) 130
- (3) static water level (feet) 45 below above top of ground.
- (4) casing galv 126 (material) (depth)
- (size) if telescope see back.
- (5) screen 4 130 (length) (depth to top)
- 2 STAINLESS (size) (material)
- (6) pump 1 8 (HP) (yield gpm)
- Elec (type power)
- (7) electric log NO (yes or no)
- (organization running log)
- (8) how well bottom plugged 2" BW

DRILLERS REMARKS:

NOV 27 1969
MISS. DEPT. OF WATER CONTROL

If well telescopes please
sketch and show depths.

GROUND LEVEL

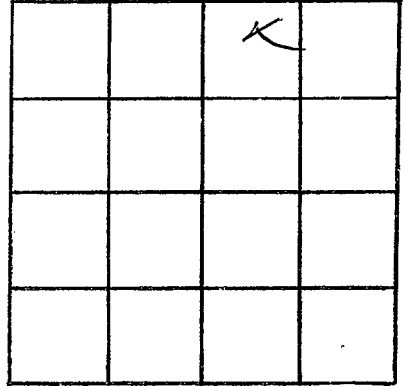

SECTION 4

Please indicate well location X.

ADDITIONAL INFORMATION

If more than one screen,
show locations of each on sketch.