

NEWTON  
P 24  
11-17-70

MISSISSIPPI  
 BOARD OF WATER COMMISSIONERS  
 416 North State Street  
 Jackson, Mississippi 39201

**CODED**

WATER WELL DRILLERS LOG

11-17 19 70 W L Welch Newton  
 date well completed firm name county well located

LANDOWNER Onnie Walker  
Newton  
Miss  
 (mailing address)

description of formations encountered	from	to
<u>red clay</u>	<u>0</u>	<u>15</u>
<u>red sand</u>	<u>15</u>	<u>30</u>
<u>W. Sand</u>	<u>30</u>	<u>51</u>

WELL LOCATION:  
 sec. 18 T 5 N R 12 E  
5 miles SE of Newton  
 (distance) (direction) (nearest town)

WELL PURPOSE:  
 (home, irrigation, municipal, industrial)

- WELL COMPLETION DATA:
- (1) diameter (inches) 2"
  - (2) total depth (feet) 51
  - (3) static water level (feet) 26 below above top of ground
  - (4) casing Steel (material) (depth)  
 (size) If telescope see back.
  - (5) screen 5 (length) (depth to top)  
2" (size) St. Steel (material)
  - (6) pump 1 (HP) 400 (yield gpm)  
elec (type power)
  - (7) electric log (yes or no)  
 (organization running log)
  - (8) how well bottom plugged


**CODED**

DRILLERS REMARKS:

NOV 30 1970

If well telescopes please sketch and show depths.

GROUND LEVEL

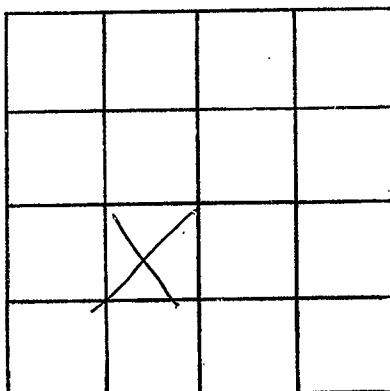

SECTION \_\_\_\_\_

Please indicate well location X.

ADDITIONAL INFORMATION

If more than one screen, show locations of each on sketch.