

NEWTON
P25
5-1-70

MISSISSIPPI
BOARD OF WATER COMMISSIONERS
416 North State Street
Jackson, Mississippi 39201

CODED

WATER WELL DRILLERS LOG

May 1 1970 Tom Dillinger's Newton
date well completed firm name county well located

LANDOWNER:
J.W. Williams
Newton, Miss.
(mailing address)

description of formations encountered	from	to
Yellow Clay	0	24
7" sand	24	40
Clay	40	60
Sand	60	83

WELL LOCATION:
sec. 29 T 5 N R 12 E
7 miles S of Newton
(distance) (direction) (nearest town)

WELL PURPOSE: HOME
(home, irrigation, municipal, industrial)

CODED

WELL COMPLETION DATA:

(1) diameter (inches) 2"
(2) total depth (feet) 83
(3) static water level (feet) 40 below top of ground.
(4) casing Galv. 77' (material), (depth)
(size) if telescope see back.
(5) screen 6' 77' (length), (depth to top)
2" Stainless S. (size), (material)
(6) pump 1 6 (HP), (yield gpm)
jet (type power)
(7) electric log No (yes or no)
(organization running log)
(8) how well bottom plugged Wash Valve


DRILLERS REMARKS:

DEC 4 1970

MISSISSIPPI
BOARD OF WATER COMMISSIONERS

If well telescopes please sketch and show depths.

GROUND LEVEL

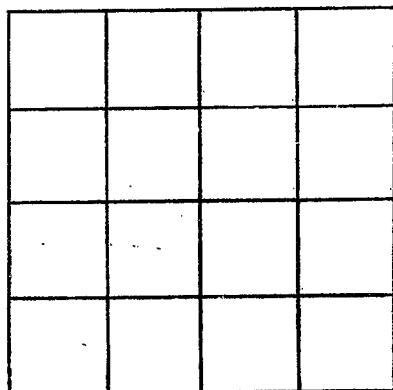

SECTION _____

Please indicate well location X.

ADDITIONAL INFORMATION

If more than one screen,
show locations of each on sketch.