

NEWTON
P 26
7-7-70

MISSISSIPPI
BOARD OF WATER COMMISSIONERS
416 North State Street
Jackson, Mississippi 39201

CODED

WATER WELL DRILLERS LOG

July 7 1970 Jerry Drilling Co. Newton
date well completed firm name county well located

LANDOWNER:	description of formations encountered	from	to
(mailing address)			
Johnny Williams Rt 1, Newton, Miss.	Yellow Clay Sand Clay Sand	0 32 50 200	32 50 200 235
WELL LOCATION: sec 29 T 5 N R 12 E 6 miles SE of Newton			
WELL PURPOSE: Home (home, irrigation, municipal, industrial)			
WELL COMPLETION DATA:			
(1) diameter (inches) 2"			
(2) total depth (feet) 235			
(3) static water level (feet) 100 below top of ground.			
(4) casing galv. 223 (material) (depth)			
(size) if telescope see back.			
(5) screen 12' 223 (length) (depth to top)			
2" Staples (size) (material)			
(6) pump 1 5 (HP) (yield gpm)			
Jet (type power)			
(7) electric log No (yes or no)			
(organization running log)			
(8) how well bottom plugged? Wash valve			
DRILLERS REMARKS:			


CODED

DEC 4 1970

MISS. BD. OF
WATER COMMISSIONERS

If well telescopes please sketch and show depths.

GROUND LEVEL

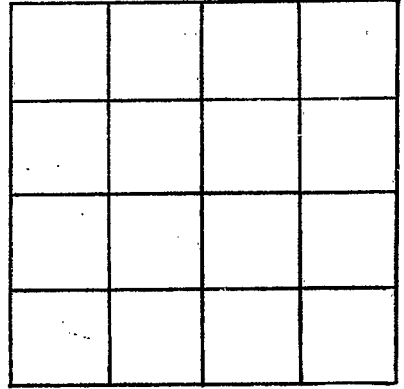

SECTION _____

Please indicate well location X.

ADDITIONAL INFORMATION

If more than one screen,
show locations of each on sketch.