

NEWTON  
P28  
3-16-71

MISSISSIPPI  
 BOARD OF WATER COMMISSIONERS  
 416 North State Street  
 Jackson, Mississippi 39201

**CODED**

WATER WELL DRILLERS LOG

3-16 1971 W. H. Threlkeld Newton  
 date well completed firm name county well located

LANDOWNER: Ned Brady  
Newton  
Miss  
 (mailing address)

WELL LOCATION:  
 sec. 19 T. 5 S. R. 12 E.  
3 miles SE of Newton  
 (distance) (direction) (nearest town)

WELL PURPOSE: Home  
 (home, irrigation, municipal, industrial)

- WELL COMPLETION DATA:
- (1) diameter (inches) 4 1/2
  - (2) total depth (feet) 360
  - (3) static water level (feet) 145 below above top of ground.
  - (4) casing \_\_\_\_\_ (material) \_\_\_\_\_ (depth) \_\_\_\_\_  
 \_\_\_\_\_ If telescope see back.  
 (size)
  - (5) screen 10 \_\_\_\_\_ (length) \_\_\_\_\_ (depth to top)  
2" \_\_\_\_\_ (size) \_\_\_\_\_ (material)
  - (6) pump 1 \_\_\_\_\_ (HP) 200 \_\_\_\_\_ (yield gpm)  
elec \_\_\_\_\_ (type power)
  - (7) electric log no \_\_\_\_\_ (yes or no)  
 \_\_\_\_\_ (organization running log)
  - (8) how well bottom plugged \_\_\_\_\_

description of formations encountered	from	to
<u>Red clay</u>	<u>0</u>	<u>40</u>
<u>Sand clay</u>	<u>40</u>	<u>80</u>
<u>Sandy</u>	<u>80</u>	<u>100</u>
<u>Blue</u>	<u>100</u>	<u>160</u>
<u>Brown</u>	<u>160</u>	<u>200</u>
<u>Brown + S. O.</u>	<u>200</u>	<u>300</u>
<u>Sand</u>	<u>300</u>	<u>360</u>

**CODED**

MAR 23 1971

MISS. BD. OF  
 WATER COM.

DRILLERS REMARKS:

If well telescopes please sketch and show depths.


GROUND LEVEL

710.5"

147' 2"

Strainer

Lead Seal

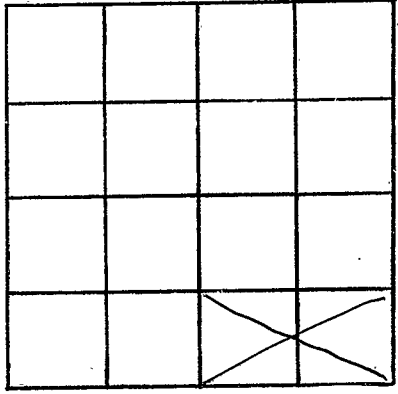

SECTION \_\_\_\_\_

Please indicate well location X.

ADDITIONAL INFORMATION

If more than one screen, show locations of each on sketch.