

NEWTON

P29

7-17-67

MISSISSIPPI
 BOARD OF WATER COMMISSIONERS
 416 North State Street
 Jackson, Mississippi 39201

CODED

WATER WELL DRILLERS LOG

7-17-67
date well completed

Best Drilling
firm name

Newton
county well located

LANDOWNER: Jedie Bradford

description of formations encountered

from to

Newton Miss
(mailing address)

<u>Clayt Sand</u>	<u>0</u>	<u>15</u>
<u>Clayt</u>		<u>77</u>
<u>Clayt</u>		<u>80</u>
<u>Clayt</u>		<u>102</u>
<u>Fine Sand with Clay</u>		<u>127</u>
<u>Fine Sand</u>		<u>183</u>
<u>" "</u>		<u>183</u>

WELL LOCATION:


sec. 20 T. 5 N. R. 12 E.
 S. W.
6 miles S/E of Newton
 (distance) (direction) (nearest town)

WELL PURPOSE:
(home, irrigation, municipal, industrial)

WELL COMPLETION DATA:

- (1) diameter (inches) 2
- (2) total depth (feet) 183
- (3) static water level (feet) 84 below above top of ground.
- (4) casing Galv. 168
(material) (depth)
2" if telescope see back.
(size)
- (5) screen 154 168
(length) (depth to top)
2" Cmn. Brass
(size) (material)
- (6) pump _____ (HP) _____ (yield gpm)
(type power)
- (7) electric log No
(yes or no)
(organization running log)
- (8) how well bottom plugged backwash
probe


CODED

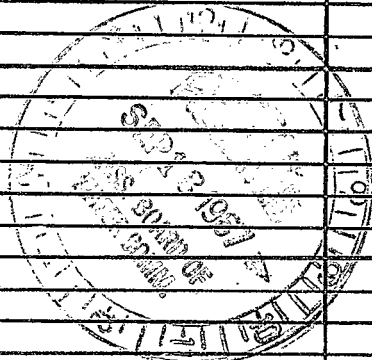

DRILLERS REMARKS:

If well telescopes please sketch and show depths.

GROUND LEVEL

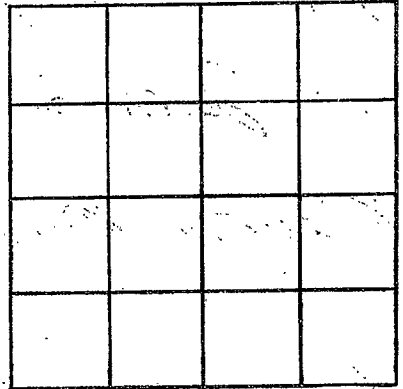

SECTION _____

Please indicate well location X.

ADDITIONAL INFORMATION

If more than one screen,
show locations of each on sketch.