

Newton
P30
8-18-72

MISSISSIPPI
 BOARD OF WATER COMMISSIONERS
 416 North State Street
 Jackson, Mississippi 39201

CODED

WATER WELL DRILLERS LOG

8-18 1972 W. L. Spelch Newton
 date well completed firm name county well located


LANDOWNER:	description of formations encountered	from	to
<u>Jerry Williams</u> <u>Newton Series</u> (mailing address)			
WELL LOCATION:	<u>Blue</u>	<u>34</u>	<u>60</u>
sec. <u>34</u> T. <u>5</u> N. R. <u>12</u> E. S. <u>8</u>	<u>Blue-W. Shell</u>	<u>60</u>	<u>130</u>
<u>8</u> miles <u>SE.</u> of <u>Newton</u>	<u>Brown + Sand</u>	<u>130</u>	<u>165</u>
(distance) (direction) (nearest town)	<u>Brown</u>	<u>165</u>	<u>210</u>
WELL PURPOSE: (home, irrigation, municipal, industrial)	<u>Sand</u>	<u>210</u>	<u>270</u>
WELL COMPLETION DATA:			
(1) diameter (inches) <u>2"</u>			
(2) total depth (feet) <u>300</u>			
(3) static water level (feet) <u>94</u> below top of ground.			
(4) casing <u>3/4" Steel</u> (material) (depth)			
(size) If telescope see back.			
(5) screen <u>10'</u> (length) (depth to top)			
<u>2 1/2"</u> (size) <u>Stainless Steel</u> (material)			
(6) pump <u>1</u> (HP) <u>320</u> (yield gpm)			
<u>elec</u> (type power)			
(7) electric log (yes or no)			
(organization running log)			
(8) how well bottom plugged			
DRILLERS REMARKS:			

AUG 24 1972

MISS. AD. OF
 WATER COMMISSIONERS

If well telescopes please sketch and show depths.

GROUND LEVEL

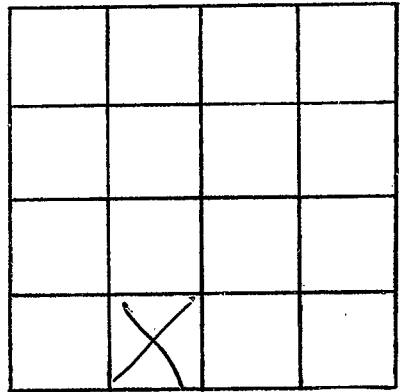

SECTION _____

Please indicate well location X.

ADDITIONAL INFORMATION

If more than one screen,
show locations of each on sketch.