

Newton
P 32
3-26-73

MISSISSIPPI
BOARD OF WATER COMMISSIONERS
416 North State Street
Jackson, Mississippi 39201

CODED

WATER WELL DRILLERS LOG

3, 26-73 date well completed
McDonald & Bill firm name
Newton county well located

LANDOWNER: SMITH

description of formations encountered	from	to
Clay	0	20
Shale	20	90
fine sand	90	130
shale	130	140
sand	140	240
sandy sh. sh.	240	285
OPEN	285	320
sh. sh.	320	340
sand sh. sh.	340	375
soft sand	375	400

(mailing address)

WELL LOCATION:
sec. 27 T-5 N R-120 W
5 miles South of Hickory
(distance) (direction) (nearest town)

WELL PURPOSE: HOME
(home, irrigation, municipal, industrial)

WELL COMPLETION DATA:


- (1) diameter (inches) 4"
- (2) total depth (feet) 400'
- (3) static water level (feet) 90' below top of ground
- (4) casing PVC 302' (material), (depth)
4" (size) if telescope see back.
- (5) screen (length) (depth to top)
(size) (material)
- (6) pump 1 (HP), 10 (yield gpm)
220 (type power)
- (7) electric log NO (yes or no)
NO (organization running log)
- (8) how well bottom plugged OPEN

DRILLERS REMARKS:

MISSISSIPPI BOARD OF WATER COMMISSIONERS

If well telescopes please sketch and show depths.

GROUND LEVEL

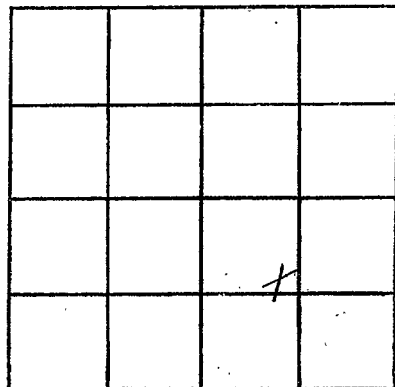

SECTION _____

Please indicate well location X.

ADDITIONAL INFORMATION

If more than one screen,
show locations of each on sketch.