

NEWTON
P 33
10-10-73

MISSISSIPPI
BOARD OF WATER COMMISSIONERS
416 North State Street
Jackson, Mississippi 39201

CODED

WATER WELL DRILLERS LOG

10.10.73
date well completed

MCDONALD + HILL
firm name

NEWTON
county well located

LANDOWNER:
Judson MEADERS
Hickory Miss
(mailing address)

description of formations encountered	from	to
CLAY	0	14
SAND	14	112
SOFT SHALE	112	120
SHALE	120	150
ROCK ST SAND	150	170
GREEN SAND	170	190
SAND	190	200
ROCK ST SHALE	200	220
SAND	220	240

WELL LOCATION:
sec 2 T 5 N R 12 E
S W
1 1/2 miles NORTH of Hickory
(distance) (direction) (nearest town)

WELL PURPOSE: HOME
(home, irrigation, municipal, industrial)

- WELL COMPLETION DATA:
- (1) diameter (inches) 4"
 - (2) total depth (feet) 340
 - (3) static water level (feet) _____ below/above top of ground.
 - (4) casing PVC 144'
(material) (depth)
4"
(size) if telescope see back.
 - (5) screen _____
(length) (depth to top)

(size) (material)
 - (6) pump 1/2 Sub 10
(HP) (yield gpm)
ELECTRIC
(type power)
 - (7) electric log _____
(yes or no)

(organization running log)
 - (8) how well bottom plugged OPEN

CODED


TIME 1 5 1973

DRILLERS REMARKS:

TABLE OF
WELL DATA
DRILLERS CONT.

If well telescopes please sketch and show depths.

GROUND LEVEL

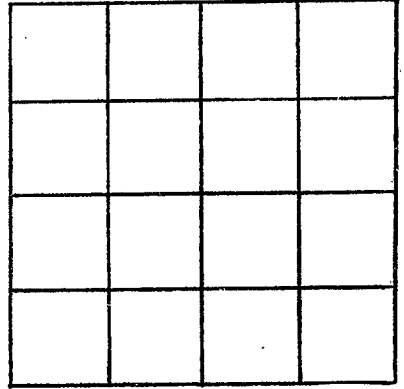

SECTION _____

Please indicate well location X.

ADDITIONAL INFORMATION

If more than one screen, show locations of each on sketch.