

NEWTON

P 34

8-7-74

MISSISSIPPI BOARD OF WATER COMMISSIONERS
416 North State Street
Jackson, Mississippi 39201

CODED

WATER WELL DRILLERS LOG

8-7

date well completed

1974 H. S. White

firm name

Newton

county well located

LANDOWNER

Mary R. White
Newton Miss

description of formations encountered

from

to

(mailing address)

WELL LOCATION:

sec. 7 T 5 N R 12 E

SW of Newton

5 miles (distance)

SW (direction)

Newton (nearest town)

WELL PURPOSE:

Home (home, irrigation, municipal, industrial)

WELL COMPLETION DATA:

- (1) diameter (inches) 2 1/2
- (2) total depth (feet) 160
- (3) static water level (feet) 39 below top of ground.
- (4) casing PVC, 160 (material) (depth)
- (size) if telescope see back.
- (5) screen 10' (length) (depth to top)
- 2 1/2" PVC (size) (material)
- (6) pump 1 HP 350 (HP) (yield gpm)
- 1/2 HP (type power)
- (7) electric log 700 (yes or no)
- (organization running log)
- (8) how well bottom plugged

Dark	10	15
Hardy	15	25
Blue	25	40
Blue sandy	40	70
S. Mass	70	120
Sand	120	160


RECEIVED

AUG 23 1974

DRILLERS REMARKS:

If well telescopes please sketch and show depths.

GROUND LEVEL

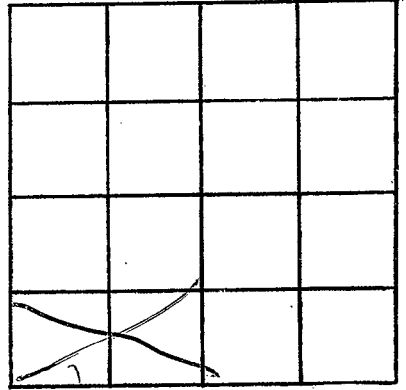

SECTION _____

Please indicate well location X.

ADDITIONAL INFORMATION

If more than one screen, show locations of each on sketch.