

NEWTON

P 35

12-23-74

MISSISSIPPI
 BOARD OF WATER COMMISSIONERS
 416 North State Street JACKSON, Mississippi 39201

CODED

WATER WELL DRILLERS LOG

12-23

1974

U. L. Welch

Newton

date well completed

firm name

county well located

LANDOWNER: S.M. Robinson

description of formations encountered

from

to

Newton Miss

(mailing address)

WELL LOCATION:

sec. 7 T. 50N R. 14E

5 miles S.E. of Newton (distance) (direction) (nearest town)

WELL PURPOSE: Home (home, irrigation, municipal, industrial)

WELL COMPLETION DATA:

- (1) diameter (inches) 3"
- (2) total depth (feet) 320
- (3) static water level (feet) 45 below top of ground.
- (4) casing pvc (material), (depth)

if telescope see back. (size)

(5) screen 15' (length), (depth to top)

2" pvc (size) (material)

(6) pump 2 (HP) 500 (yield gpm)


elec (type power)

(7) electric log (yes or no)

(organization running log)

(8) how well bottom plugged

Clay Red	0	10
Sandy	18	35
Blue	35	72
Shall	72	80
Grey CODED	80	160
Brown	160	220
Brown + Sand	220	240
Sand	240	320

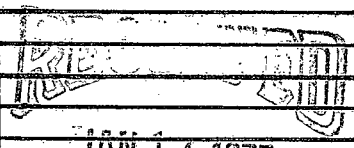

JAN 14 1975

WATER COMM

DRILLERS REMARKS:

Surfing with elec

