

NEWTON
P 36
316178

MISSISSIPPI
BOARD OF WATER COMMISSIONERS **COULD**
416 North State Street
Jackson, Mississippi 39201

WATER WELL DRILLERS LOG

3/6/78
date well completed

19 Graver Drilling Service
firm name

Newton
county well located

LANDOWNER: Hunt Energy

7-15 Lucy

(mailing address)

WELL LOCATION:

sec. 7 T. 5 (N) R. 12 (E)
660 N + 2120 W of SE/Cor of Newton
miles (distance) (direction) (nearest town)

WELL PURPOSE:

(home, irrigation, municipal, industrial)

WELL COMPLETION DATA:

- (1) diameter (inches) 3"
- (2) total depth (feet) 300
- (3) static water level (feet) 50 ^{below} top of ground.
- (4) casing Steel 273'
(material) (depth)
3"
(size) if telescope see back.
- (5) screen 42' 231'
(length) (depth to top)
3" Perforated Pipe
(size) (material)
- (6) pump 70
(HP) (yield gpm)
AC
(type power)
- (7) electric log NO
(yes or no)
- (organization running log)

(8) how well bottom plugged Orange
Red

DRILLERS REMARKS:

description of formations encountered

from to

Clay, Sand Clay	0	21
Sand Clay	21	42
Clay + Rocks	42	105
Shale	105	136
Sand	136	168
Chalk	168	189
Shales	189	210
Sand + Small Pea Gravel	210	280
Chalk	280	300


RECEIVED

MAR 30 1978

MISS. BD. OF WATER COMMISSIONERS

If well telescopes please sketch and show depths.

GROUND LEVEL

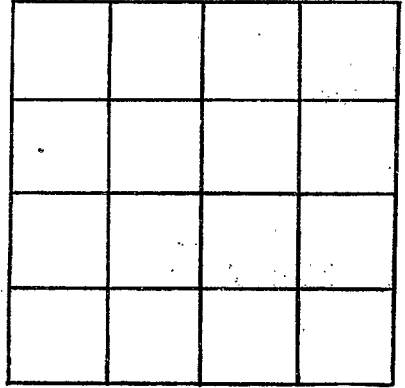

SECTION _____

Please indicate well location X.

ADDITIONAL INFORMATION

If more than one screen, show locations of each on sketch.