

MISSISSIPPI DEPARTMENT OF NATURAL RESOURCES

Bureau of Land and Water Resources

Southport Mall

P.O. Box 10631

Jackson, Mississippi 39209

WATER WELL DRILLERS LOG

NEWTON
P 37
5-13-85

5-13 1985 McDONALD HILL NEWTON
 date well completed firm name county well located

LANDOWNER:	description of formations encountered	from	to
Bob + MAMIE WALKER			
Rt 1 Box 19 Hickory Miss (mailing address)	BLUE CLAY	20	40
	SHELLS ST SAND	40	60
	SHALE	60	80
	FINE SAND ST SHALE	80	134
	SHALE	134	150
	FINE SAND	150	160
	COARSE SAND ST SHALE	160	180

WELL LOCATION:
 sec. 20 T. 20 N. R. 12 E
 6 miles SOUTH of HICKORY
 (distance) (direction) (nearest town)

WELL PURPOSE: W O R K E
 (home, irrigation, municipal, industrial)

WELL COMPLETION DATA:

(1) diameter (inches) 4"

(2) total depth (feet) 180'

(3) static water level (feet) 130' below above top of ground.

(4) casing PVC 170'
 (material) (depth)
4" if telescope see back.
 (size)

(5) screen 10' 170'
 (length) (depth to top)
4" PVC
 (size) (material)

(6) pump 1/2 8
 (HP) (yield gpm)
E
 (type power)

(7) electric log NO
 (yes or no)
NO
 (organization running log)


(8) how well bottom plugged VALVE

RECEIVED
 MAY 16 1985
 Department of Natural Resources
 Bureau of Land & Water Resources

DRILLERS REMARKS:
SET PUMP
170'

If well telescopes please
sketch and show depths.

GROUND LEVEL

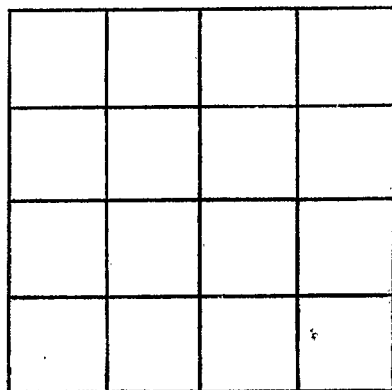

SECTION _____

Please indicate well location X.

ADDITIONAL INFORMATION

If more than one screen,
show locations of each on sketch.