

Newton

P 2000

11-21-75

MISSISSIPPI  
 BOARD OF WATER COMMISSIONERS  
 416 North State Street  
 Jackson, Mississippi 39201

WATER WELL DRILLERS LOG

11-21

1975 U. L. Welch

Newton

date well completed

firm name

county well located

LANDOWNER:

Popular Springs Church  
Newton Miss  
(mailing address)

description of formations encountered

from to

Gand	0	36
Blue	36	70
Grey & Shell	70	100
Grey	100	150
Iron	160	200
Gand	200	245

WELL LOCATION:

sec. 5 T. 5 S. R. 12 E.  
4 miles E of Newton  
(distance) (direction) (nearest town)

WELL PURPOSE:

(home, irrigation, municipal, industrial)

WELL COMPLETION DATA:

- (1) diameter (inches) 2"
- (2) total depth (feet) 245
- (3) static water level (feet) 133 below top of ground.
- (4) casing 2 1/2" S. Steel (material) (depth)
- (size) if telescope see back.
- (5) screen 6' (length) (depth to top)
- 2 1/2" S. Steel (size) (material)
- (6) pump 1/2 (HP) 240 gpm (yield gpm)
- 240 (type power)
- (7) electric log (yes or no)
- (organization running log)
- (8) how well bottom plugged

REGISTERED  
 DEC - 9 1975


MISS. DEP. OF WATER CONTROL

DRILLERS REMARKS:

This is a  
rod pump

If well telescopes please sketch and show depths.

GROUND LEVEL

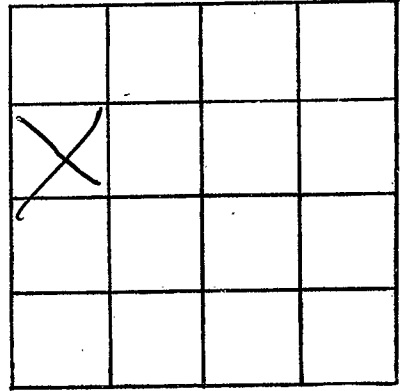

SECTION \_\_\_\_\_

Please indicate well location X.

ADDITIONAL INFORMATION

If more than one screen,  
show locations of each on sketch.