

NEWTON
P 2001
4-14-77

MISSISSIPPI
BOARD OF WATER COMMISSIONERS
416 North State Street
Jackson, Mississippi 39201

WATER WELL DRILLERS LOG

4-14-77 19 McDonald & Hill Newton
date well completed firm name county well located

LANDOWNER:
Wayne Massey
(mailing address)

WELL LOCATION:
sec. 10 T. 5N R. 12E
6 miles SW of Chunky
(distance) (direction) (nearest town)

WELL PURPOSE: Home
(home, irrigation, municipal, industrial)

WELL COMPLETION DATA:
(1) diameter (inches) 4"
(2) total depth (feet) 320'
(3) static water level (feet) 95' below top of ground.
(4) casing PVC, 130' (material) (depth)
4" (size) if telescope see back.
(5) screen (length) (depth to top) (size) (material)
(6) pump 10 (HP) 600 GPM. (type power) E
(7) electric log (yes or no) (organization running log)
(8) how well bottom plugged open

| description of formations encountered | from | to |
|---------------------------------------|------|-----|
| sand & clay | 0 | 25 |
| sand | 25 | 90 |
| sandy shale | 90 | 115 |
| shale | 115 | 135 |
| Rock & shells | 135 | 155 |
| green sand | 155 | 170 |
| shale & rock | 170 | 290 |
| coarse sand | 290 | 320 |

RECEIVED


APR 18 1977

DRILLERS REMARKS:

MISS. BD. OF WATER COMM.

If well telescopes please sketch and show depths.

GROUND LEVEL

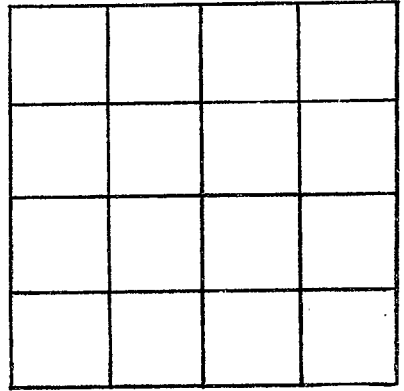

SECTION _____

Please indicate well location X.

ADDITIONAL INFORMATION

If more than one screen,
show locations of each on sketch.