

NEWTON
P 2003
4/6/78

MISSISSIPPI
BOARD OF WATER COMMISSIONERS
 416 North State Street
 Jackson, Mississippi 39201

WATER WELL DRILLERS LOG

4-6-78 19 McDonald & Hill Newton
 date well completed firm name county well located

LANDOWNER:
W. A. Brock
Rt # 2 Newton
 (mailing address)

WELL LOCATION:
 sec. 4 T. 5 N. R. 13 E.
4 miles SE of Newton
 (distance) (direction) (nearest town)

WELL PURPOSE: home
 (home, irrigation, municipal, industrial)

WELL COMPLETION DATA:

- diameter (inches) 4"
- total depth (feet) 300'
- static water level (feet) 60' below top of ground.
- casing PVC, 240'
 (material) (depth)
4" If telescope see back.
 (size)
- screen _____
 (length) (depth to top)
 (size) (material)
- pump 1/2 6 GPM
 (HP) (yield gpm)
E
 (type power)
- electric log _____
 (yes or no)
 (organization running log)
- how well bottom plugged open


description of formations encountered	from	to
clay & sand	0	20
sand & st clay	20	45
shale	45	90
sand	90	200
sandy shale	200	220
shale	220	248
Rocks & shells	248	275
green sand & sandy shale	275	300

RECEIVED
APR 10 1978
 MISSISSIPPI BOARD OF WATER COMMISSIONERS

DRILLERS REMARKS:

If well telescopes please
sketch and show depths.

GROUND LEVEL

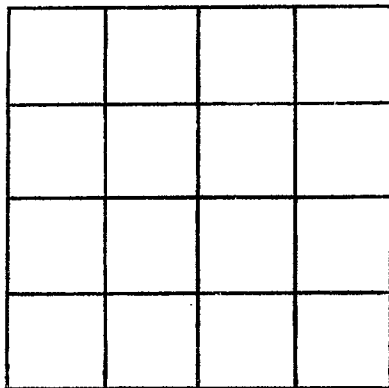

SECTION _____

Please indicate well location X.

ADDITIONAL INFORMATION

If more than one screen,
show locations of each on sketch.