

Newton
P 2004
12-5-79

MISSISSIPPI
 BOARD OF WATER COMMISSIONERS
 416 North State Street
 Jackson, Mississippi 39201

WATER WELL DRILLERS LOG

12-5-79 19 McDonald + Kell Newton
 date well completed firm name county well located
Club.

LANDOWNER: <u>Edwin Robinson</u>	description of formations encountered	from	to
(mailing address)			
<u>Hickory</u>	<u>clay</u>	<u>0</u>	<u>10</u>
	<u>sand + clay</u>	<u>10</u>	<u>20</u>
	<u>shale</u>	<u>20</u>	<u>110</u>
	<u>shale + fine sand</u>	<u>110</u>	<u>135</u>
	<u>course sand</u>	<u>135</u>	<u>145</u>

WELL LOCATION:
 sec. 2 T. 5 N R. 12 E
3 miles SW of Hickory
 (distance) (direction) (nearest town)

WELL PURPOSE: home
 (home, irrigation, municipal, industrial)

- WELL COMPLETION DATA:
- diameter (inches) 2"
 - total depth (feet) 145'
 - static water level (feet) 24' below top of ground.
 - casing PVC, 140'
 (material) (depth)
2" if telescope see back.
 (size)
 - screen 5', 140 to 145'
 (length) (depth to top)
2" PVC
 (size) (material)
 - pump 1/2 690m
 (HP) (y/d gpm)
E
 (type power)
 - electric log —
 (yes or no)
—
 (organization running log)
 - how well bottom plugged value

DEPT. OF NATURAL RESOURCES
 BUREAU OF LAND & WATER RESOURCES


DEC 11 1979

RECEIVED

DRILLERS REMARKS:

If well telescopes please sketch and show depths.

GROUND LEVEL

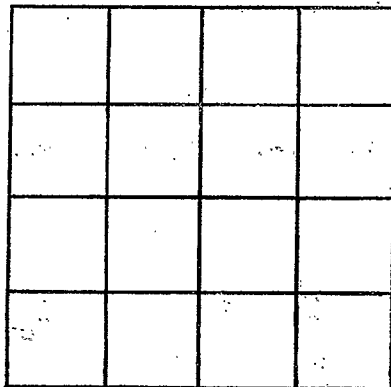

SECTION _____

Please indicate well location X.

ADDITIONAL INFORMATION

If more than one screen,
show locations of each on sketch.