

Newton
P 2006
4-2-81

MISSISSIPPI
 BOARD OF WATER COMMISSIONERS
 416 North State Street
 Jackson, Mississippi 39201

WATER WELL DRILLERS LOG

4-2-81 19 McDonald & K. D. Newton
 date well completed firm name county well located

LANDOWNER:	description of formations encountered	from	to
<u>Tom Harrison</u>	<u>Clay & sand</u>	<u>0</u>	<u>20</u>
<u>Rt # 3 Newton</u> (mailing address)	<u>shale</u>	<u>20</u>	<u>40</u>
WELL LOCATION: sec <u>5</u> T <u>3</u> N R <u>12</u> E <u>5</u> miles <u>SE</u> of <u>Newton</u> (distance) (direction) (nearest town)	<u>sandy shale</u>	<u>40</u>	<u>60</u>
	<u>shale & sand</u>	<u>60</u>	<u>120</u>
	<u>sand</u>	<u>120</u>	<u>200</u>
WELL PURPOSE: <u>home</u> (home, irrigation, municipal, industrial)	<u>sandy shale</u>	<u>200</u>	<u>255</u>
WELL COMPLETION DATA:	<u>shale</u>	<u>255</u>	<u>285</u>
(1) diameter (inches) <u>4"</u>	<u>rock & shells</u>	<u>285</u>	<u>310</u>
(2) total depth (feet) <u>330'</u>	<u>green sand</u>	<u>310</u>	<u>330</u>
(3) static water level (feet) <u>95'</u> below above ground			
(4) casing <u>PVC 280'</u> (material) (depth) <u>4"</u> if telescope see back. (size)			
(5) screen _____ (length) (depth to top) _____ (size) (material)			
(6) pump <u>1/2</u> <u>109.0m</u> (HP) (yield gpm) <u>E</u> (type power)			
(7) electric log _____ (yes or no) _____ (organization running log)			
(8) how well bottom plugged <u>Open</u>			
DRILLERS REMARKS:			


DEPT. OF NATURAL RESOURCES
 BUREAU OF LAND & WATER RESOURCES

APR - 6 1981

RECEIVED

If well telescopes please sketch and show depths.

GROUND LEVEL

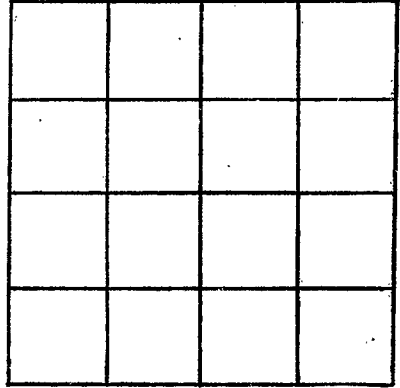

SECTION _____

Please indicate well location X.

ADDITIONAL INFORMATION

If more than one screen,
show locations of each on sketch.