

MISSISSIPPI DEPARTMENT OF NATURAL RESOURCES

Bureau of Land and Water Resources

Southport Mall

P.O. Box 10631

Jackson, Mississippi 39209

WATER WELL DRILLERS LOG

NEWTON
P 2007
6/3/81

6-3-81

McDonald & Hill


Newton

date well completed

firm name


county well located

LANDOWNER:	description of formations encountered	from	to
<u>ardell Edison</u>	<u>clay & sand</u>	<u>0</u>	<u>10</u>
<u>Rt #1 Hickory</u> (mailing address)	<u>shale</u>	<u>10</u>	<u>40</u>
WELL LOCATION:	<u>loamy shale & shell</u>	<u>40</u>	<u>100</u>
sec. <u>26</u> T. <u>5</u> N R. <u>12</u> E	<u>fine sand & shells</u>	<u>100</u>	<u>140</u>
<u>7</u> miles <u>S</u> of <u>Hickory</u>	<u>shale</u>	<u>140</u>	<u>150</u>
(distance) (direction) (nearest town)	<u>sand</u>	<u>150</u>	<u>200</u>
WELL PURPOSE: <u>home</u> (home, irrigation, municipal, industrial)			
WELL COMPLETION DATA:			
(1) diameter (inches) <u>2"</u>			
(2) total depth (feet) <u>200'</u>			
(3) static water level (feet) <u>112'</u> below above top of ground.			
(4) casing <u>PVC 195'</u> (material) (depth)			
<u>2"</u> (size) if telescope see back.			
(5) screen <u>5' 195' to 200'</u> (length) (depth to top)			
<u>2"</u> <u>PVC</u> (size) (material)			
(6) pump <u>1 49gpm</u> (HP) (field gpm)			
(type power)			
(7) electric log <u> </u> (yes or no)			
(organization running log)			
(8) how well bottom plugged <u>value</u>			
DRILLERS REMARKS:			

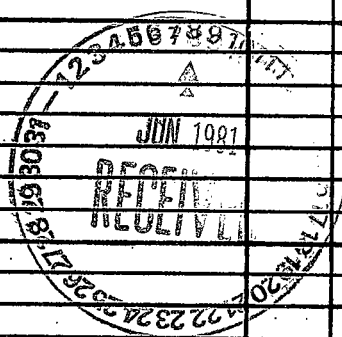

If well telescopes please
sketch and show depths.

GROUND LEVEL

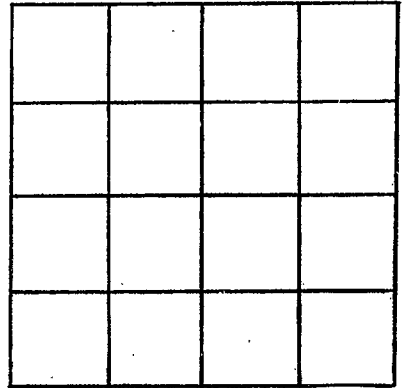

SECTION _____

Please indicate well location X.

ADDITIONAL INFORMATION

If more than one screen,
show locations of each on sketch.