

MISSISSIPPI DEPARTMENT OF NATURAL RESOURCES

Bureau of Land and Water Resources

Southport Mall

P.O. Box 10631

Jackson, Mississippi 39209

WATER WELL DRILLERS LOG

Newton  
P  
2009

7-7-82 19 McDonald's Hill Newton  
date well completed firm name county well located

LANDOWNER:  
Rubin Latimer  
P.O.# 1 Hickory  
(mailing address)

description of formations encountered  
Clay  
sandy shale  
fine sandy shale  
course sand

from to  
0 20  
80 120  
130 165  
165 190

WELL LOCATION:  
sec 27 T 5 N R 12 E  
8 S S W Hickory  
(distance) (direction) (nearest to)

WELL PURPOSE: home  
(home, irrigation, municipal, industrial)

WELL COMPLETION DATA:

- (1) diameter (inches) 4"
- (2) total depth (feet) 190'
- (3) static water level (feet) 130' below top of ground.
- (4) casing PVC 195' (material) (depth)  
2" (size) if telescope see back.
- (5) screen 5 185 to 190' (length) (depth to top)  
4" PVC (size) (material)
- (6) pump 3/4 8gpm (HP) (yield gpm)  
K (type power)
- (7) electric log (yes or no)  
(organization running log)
- (8) how well bottom plugged Valve

Set Pump  
180'

DEPT OF NATURAL RESOURCES  
BUREAU OF LAND & WATER RESOURCES


JUL 12 1982

RECEIVED

DRILLERS REMARKS:

If well telescopes please sketch and show depths.

GROUND LEVEL

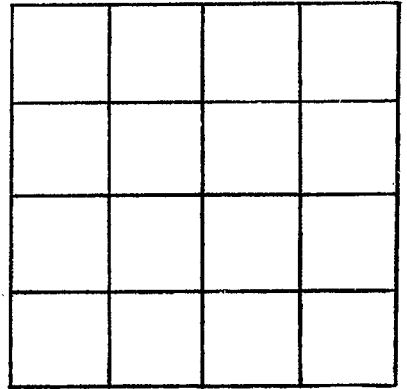

SECTION \_\_\_\_\_

Please indicate well location X.

ADDITIONAL INFORMATION

If more than one screen,  
show locations of each on sketch.