

MISSISSIPPI DEPARTMENT OF NATURAL RESOURCES

Bureau of Land and Water Resources

Southport Mall

P.O. Box 10631

Jackson, Mississippi 39209

WATER WELL DRILLERS LOG

Newton
P
2010

8-17-82 19
date well completed

McDonalds Hill
firm name

Newton
county well located

LANDOWNER:
James Rounds
Pt #2 Box 133, Newton
(mailing address)

description of formations encountered	from	to
clay	0	10
sand	10	25

WELL LOCATION:
sec. 8 T 5 N R 12 E
5 miles SE of Newton
(distance) (direction) (nearest town)

sandy shale	25	55
sandy shale	55	105
shale	105	125

WELL PURPOSE: home
(home, irrigation, municipal, industrial)

sand	125	230
------	-----	-----

WELL COMPLETION DATA:
 (1) diameter (inches) 4"
 (2) total depth (feet) 360
 (3) static water level (feet) 85' below top of ground.
 (4) casing PVC 280 (material), (depth)
 4" (size) if telescope see back.
 (5) screen (length) (depth to top)
 (size) (material)
 (6) pump 3/4 (HP), 80 gpm (yield gpm)
 (type power)
 (7) electric log (yes or no)
 (organization running log)
 (8) how well bottom plugged open

sandy shale	230	260
shale	260	302
Rock & shells	302	330
green sand & sandy shale	330	360

DEPT. OF NATURAL RESOURCES
BUREAU OF LAND & WATER RESOURCES


AUG 30 1982

RECEIVED

DRILLERS REMARKS:

If well telescopes please sketch and show depths.

GROUND LEVEL

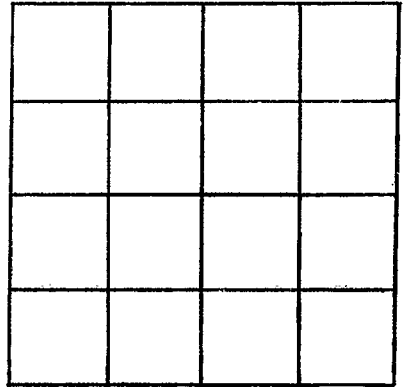

SECTION _____

Please indicate well location X.

ADDITIONAL INFORMATION

If more than one screen,
show locations of each on sketch.