

NEWTON
P 2518
9-2-76

MISSISSIPPI
 BOARD OF WATER COMMISSIONERS
 416 North State Street
 Jackson, Mississippi 39201

WATER WELL DRILLERS LOG

9-2-76 19 McDonald & Hill Newton
 date well completed firm name county well located

LANDOWNER:
Charles Little
R#1 Newton
 (mailing address)

WELL LOCATION:
 sec. S T 5 R 12 E
4 miles S.E of Newton
 (distance) (direction) (nearest town)

WELL PURPOSE: HOME
 (home, irrigation, municipal, industrial)

WELL COMPLETION DATA:

(1) diameter (inches) 4"
 (2) total depth (feet) 290'
 (3) static water level (feet) 105 below above top of ground.
 (4) casing PVC 303'
 (material) (depth)
4" if telescope see back.
 (size)
 (5) screen _____
 (length) (depth to top)
 (size) (material)
 (6) pump CCW
 (HP) (yield gpm)
 (type power) _____
 (7) electric log _____
 (yes or no)
 (organization running log) _____
 (8) how well bottom plugged OPEN


description of formations encountered	from	to
<u>sandy clay</u>	<u>0</u>	<u>8</u>
<u>clay</u>	<u>8</u>	<u>14</u>
<u>shale</u>	<u>14</u>	<u>20</u>
<u>sandy shale st. shells</u>	<u>20</u>	<u>37</u>
<u>sand st. clay</u>	<u>37</u>	<u>50</u>
<u>shale</u>	<u>50</u>	<u>72</u>
<u>sandy shale st. shells</u>	<u>72</u>	<u>85</u>
<u>shale</u>	<u>85</u>	<u>95</u>
<u>shale st. sand</u>	<u>95</u>	<u>150</u>
<u>sand</u>	<u>150</u>	<u>270</u>
<u>sandy</u>	<u>270</u>	<u>285</u>
<u>shale</u>	<u>285</u>	<u>330</u>
<u>rock st. shale</u>	<u>330</u>	<u>355</u>
<u>sand + dr. nd. shale</u>	<u>355</u>	<u>380</u>

RECEIVED
 SEP 9 1976
 MISS. BD. OF WATER COMMISSIONERS

DRILLERS REMARKS:
Turn left this side of experimental station
Go across R.R. - Go to Cross Rde turn Right.
Go to popular Springs Church - Turn Right
1st mobile home on Right

If well telescopes please sketch and show depths.

GROUND LEVEL

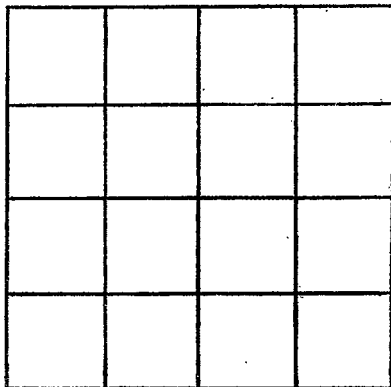

SECTION _____

Please indicate well location X.

ADDITIONAL INFORMATION

If more than one screen, show locations of each on sketch.