

Q 2

6-25-62

WATER WELL DRILLERS LOG

Date: 6-25, 1962 Driller: M. McDonald & Hill County Newton


- (1) Owner of Land: W. H. GRIFFIS  
(Name)  
Chunky, Miss.  
(Address)
- (2) Location: 1/4, 1/4, Sec. 2 S N 13 E  
(distance) (direction) (Nearest Town)
- (3) Topography:  (Hilly)  (Flat)  (Level)
- (4) Purpose of Well: Domestic  
(Domestic Irrigation, Municipal, Industrial, Other)

Description & Color of Materials Sand, Clay, Red Clay, Shell, etc.	Thick- ness Feet	Depth Feet
CLAY	0	26
Shale	26	58
Shale & St. Rocks	58	200
Shale	200	220
Sandy & Fine Sand	220	240
Sand	240	264
Shale	264	290
SAND	290	340

Information upon completion of well:

- (1) Diameter 4" inches.
- (2) Total Depth 340' feet.
- (3) Water Level 78' feet below top of ground.
- (4) Cased to 270', Size 4"
- (5) Screen: Size \_\_\_\_\_, Length \_\_\_\_\_
- (6) Were any formations sealed against pollution?  
\_\_\_\_\_ yes,  no.

If YES depth of formation \_\_\_\_\_  
Why \_\_\_\_\_  
Drillers Remarks: \_\_\_\_\_

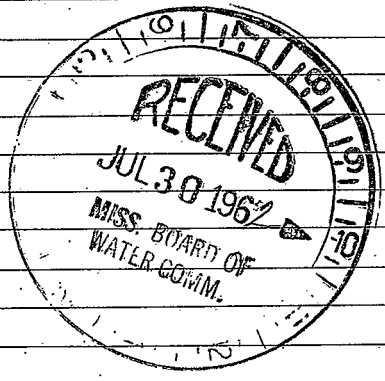

(Use Back Side)

Well No.

RESEARCH REPORT

The following text is a transcription of a document page, which appears to be a research report or a set of notes. The text is extremely faint and largely illegible due to the quality of the scan. It contains several lines of text, some of which appear to be headings or section markers, but the specific content cannot be accurately transcribed. The text is organized into paragraphs and possibly lists or tables, but the details are obscured by the low contrast of the image.