

Q3

WATER WELL DRILLERS LOG

8-22-63

Date: 8-22, 1963, Driller: Donald A. Hill County Newton

(Name)

(1) Owner of Land: Albert Russell (Name)

Rt #1, Chunky, Miss (Address)


(2) Location: 1/4, 1/4, Sec. 11 T. R. SN 13E

3 miles South of Chunky (distance, direction, Nearest Town)

(3) Topography: Hills (Hilly, Flat, Level)

(4) Purpose of Well: Domestic (Domestic Irrigation, Municipal, Industrial, Other)

Description & Color of Materials Sand, Clay, Red Clay, Shell, etc.	Thickness Feet	Depth Feet
Clay	4	4
Red soil	96	100
shale	35	135
lime	50	185
shale	96	281
lime	118	399
shale	215	614
sand	230	844
sandy shale	233	1077
fine sand	237	1314
coarse sand	260	1574

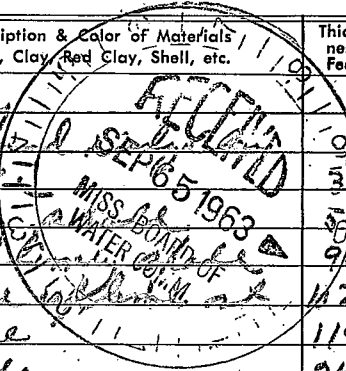

Information upon completion of well:

(1) Diameter 3 7/8 inches.

(2) Total Depth 281 feet.

(3) Water Level 90 feet below top of ground.

(4) Cased to 273, Size 2"

(5) Screen: Size 2, Length 6

(6) Were any formations sealed against pollution? yes, no.

If YES depth of formation

Why

Drillers Remarks:

(Use Back Side)

Well No. 181

