

Newton
Q5
7-68

MISSISSIPPI
BOARD OF WATER COMMISSIONERS
416 North State Street
Jackson, Mississippi 39201

WATER WELL DRILLERS LOG

7.18.68 date well completed
McDONALD + HILL firm name
NEWTON county well located

LANDOWNER: GEORGE GABER
Chunky Miss
(mailing address)

description of formations encountered	from	to
CLAY SAND	0	60
SHALE	100	90
SANDY	90	125
SHALE ST. BANK	125	260
SAND	260	300

WELL LOCATION:
sec. L T 5 N R 13 E
S W
3 miles SEAS of CHUNKY
(distance) (direction) (nearest town)

WELL PURPOSE: HOME
(home, irrigation, municipal, industrial)


- WELL COMPLETION DATA:
- (1) diameter (inches) 4 1/4
 - (2) total depth (feet) 300'
 - (3) static water level (feet) 150' below top of ground.
 - (4) casing BLK 1168'
(material) (depth)
4 1/4 if telescope see back.
(size)
 - (5) screen _____
(length) (depth to top)
(size) (material)
 - (6) pump 34 10
(HP) (yield gpm)
220
(type power)
 - (7) electric log NO
(yes or no)
(organization running log)
 - (8) how well bottom plugged OPEN

DRILLERS REMARKS:

JUL 22 1968
MISS. BOARD OF
WATER COMM.

If well telescopes please sketch and show depths.

GROUND LEVEL

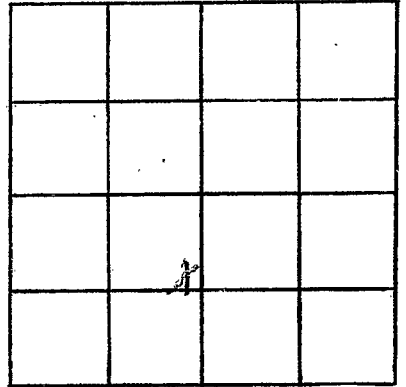

SECTION _____

Please indicate well location X.

ADDITIONAL INFORMATION

If more than one screen,
show locations of each on sketch.